

Form A1-187
March 1961

UNITED STATES
DEPARTMENT OF THE INTERIOR
BUREAU OF LAND MANAGEMENT

SECTION


SW $\frac{1}{4}$ NE $\frac{1}{4}$

Oregon State Water Filings

SEC 25

TOWNSHIP 25 S, RANGE 24 E, W. M.

North

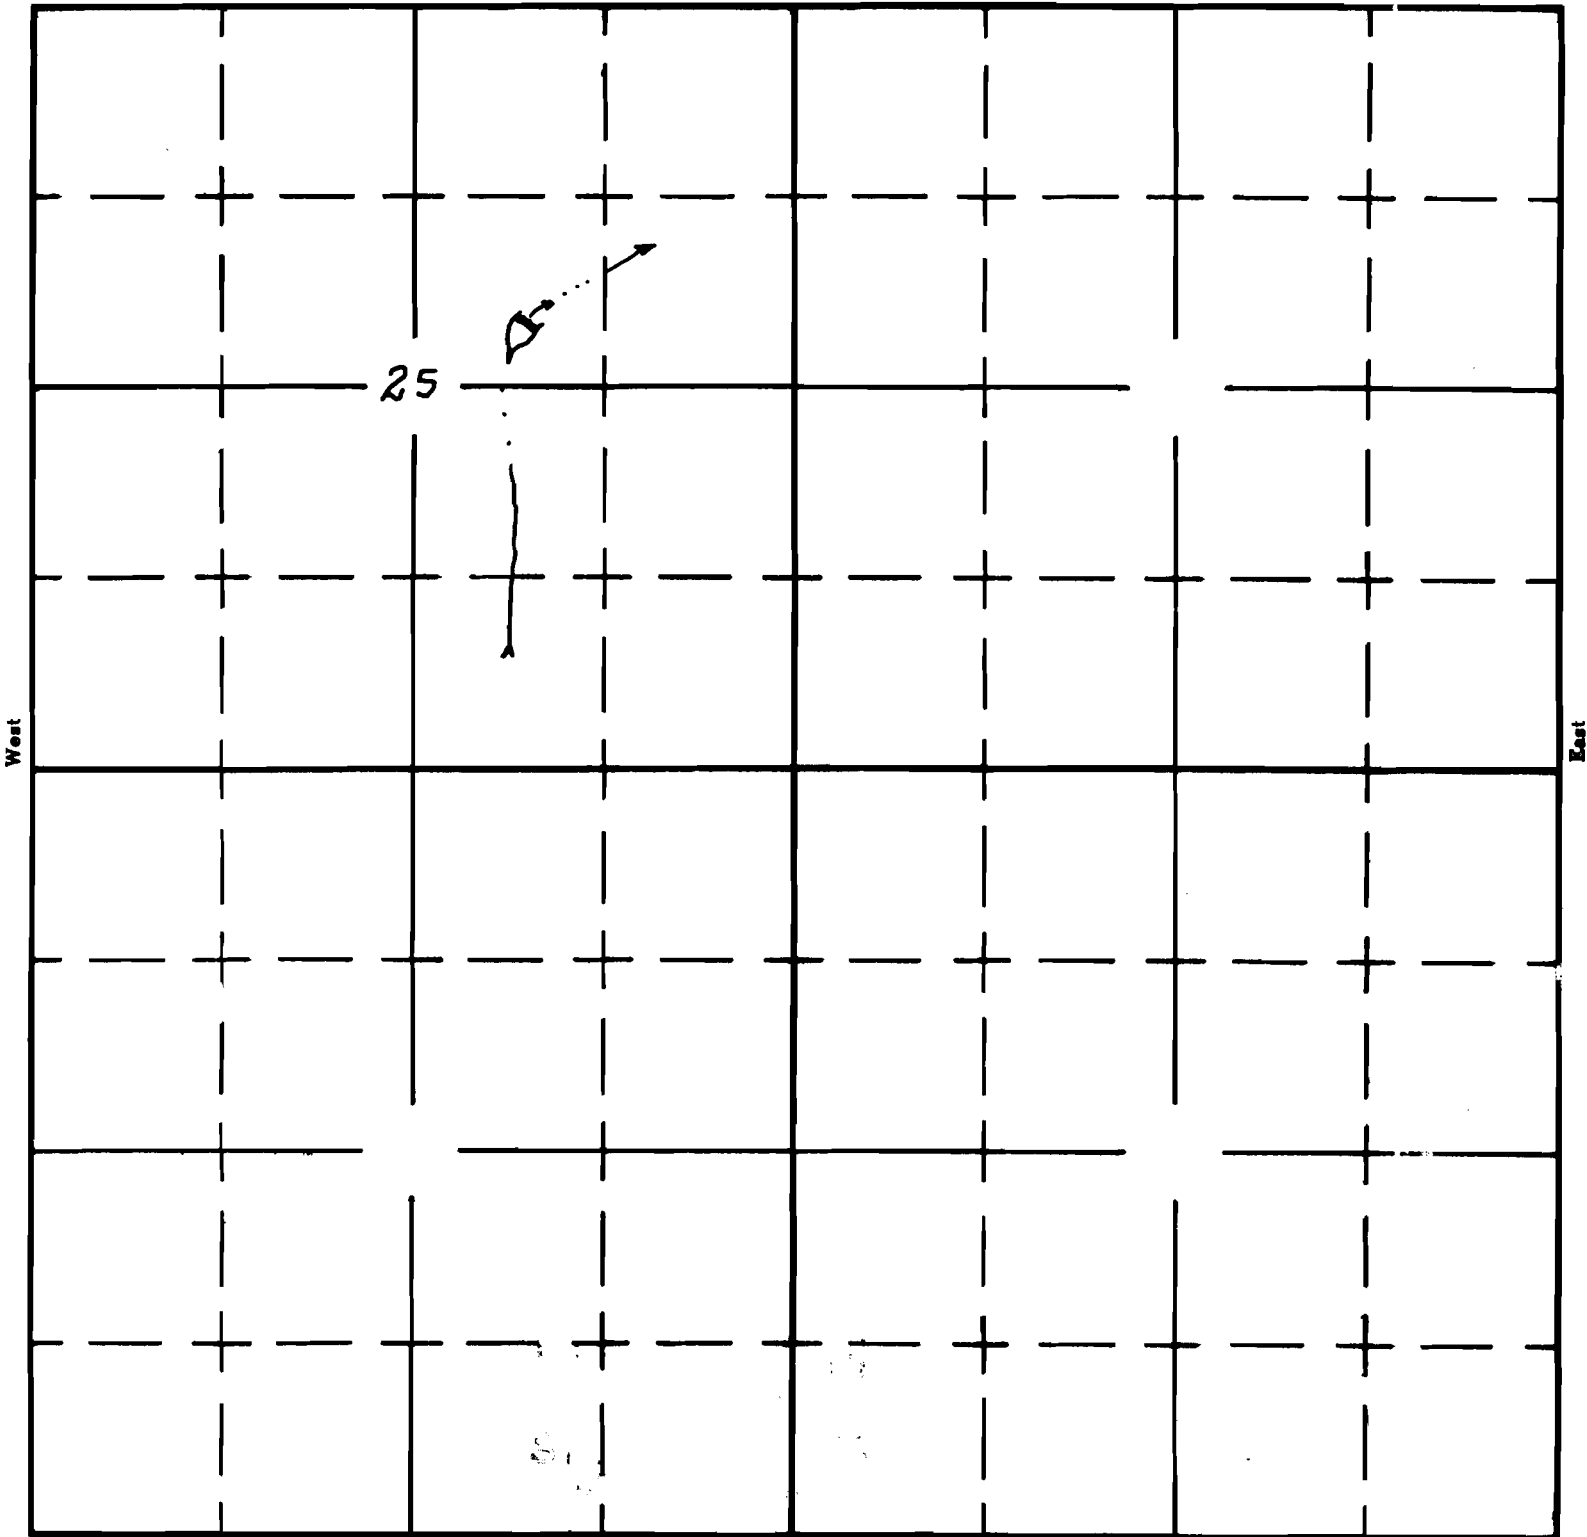

UNAPPORTIONED

South

APPLICATION No. R-35692

PERMIT No. R-4042