

Form A1-187
March 1961

UNITED STATES
DEPARTMENT OF THE INTERIOR
BUREAU OF LAND MANAGEMENT

SECTION


Lot 2

Oregon State Water Filings

SEC 1

TOWNSHIP 29S, RANGE 26E, W. M.

North

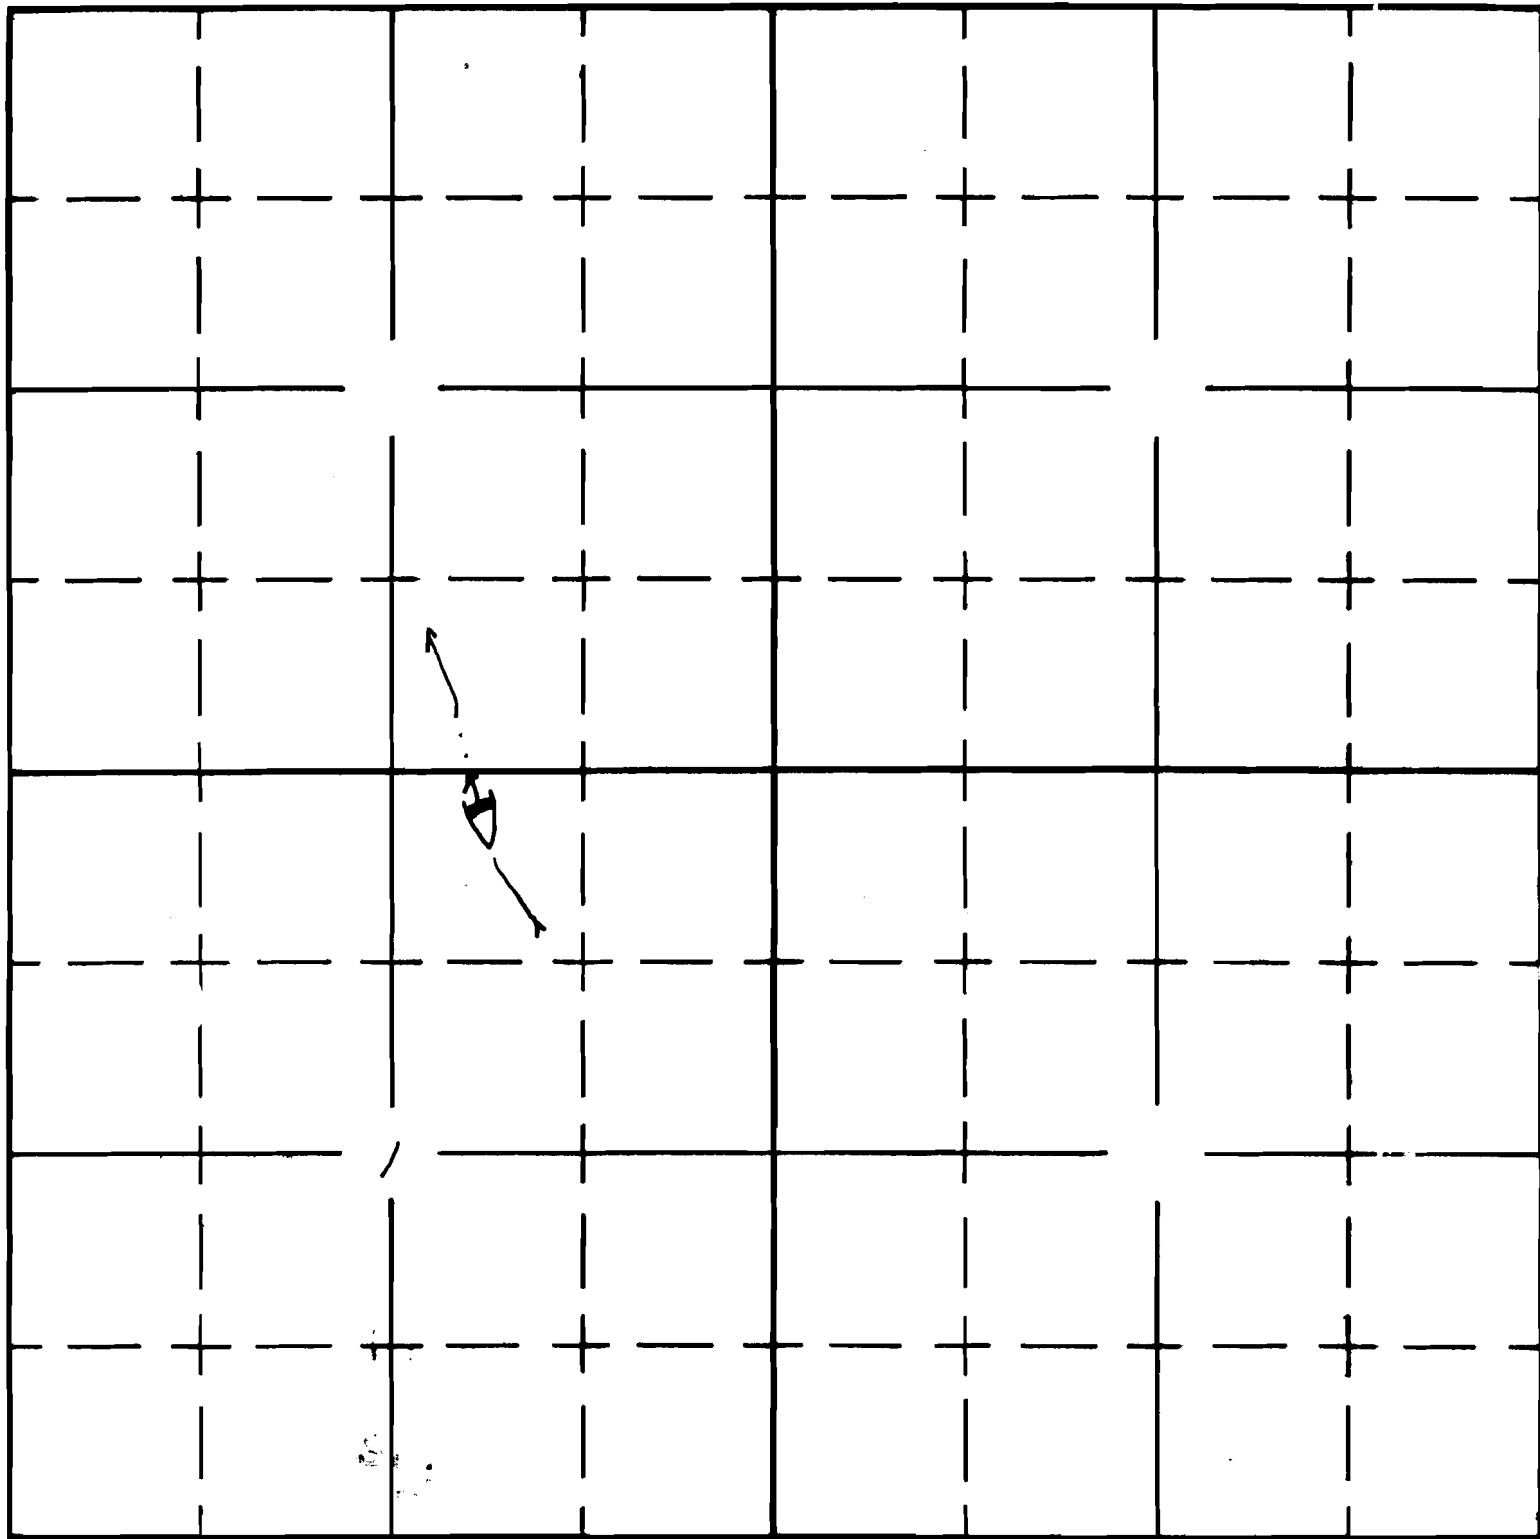

South

APPLICATION No. R-35706

PERMIT No. R-4050