

Form A1-187
March 1961
T30s R 29E
NWNE
SECS

UNITED STATES
DEPARTMENT OF THE INTERIOR
BUREAU OF LAND MANAGEMENT

RECEIVED

SEP 21 1987


SECTION
~~32~~
Sec 5
~~SE 1/4~~ ~~SE 1/4~~
NWNE

Oregon State Water Filings

TOWNSHIP 29S, RANGE 29E, W. M.

WATER RESOURCES DEPT.
SALEM, OREGON

Handwritten note: View is with aerial photo: 23.46 Quad Map

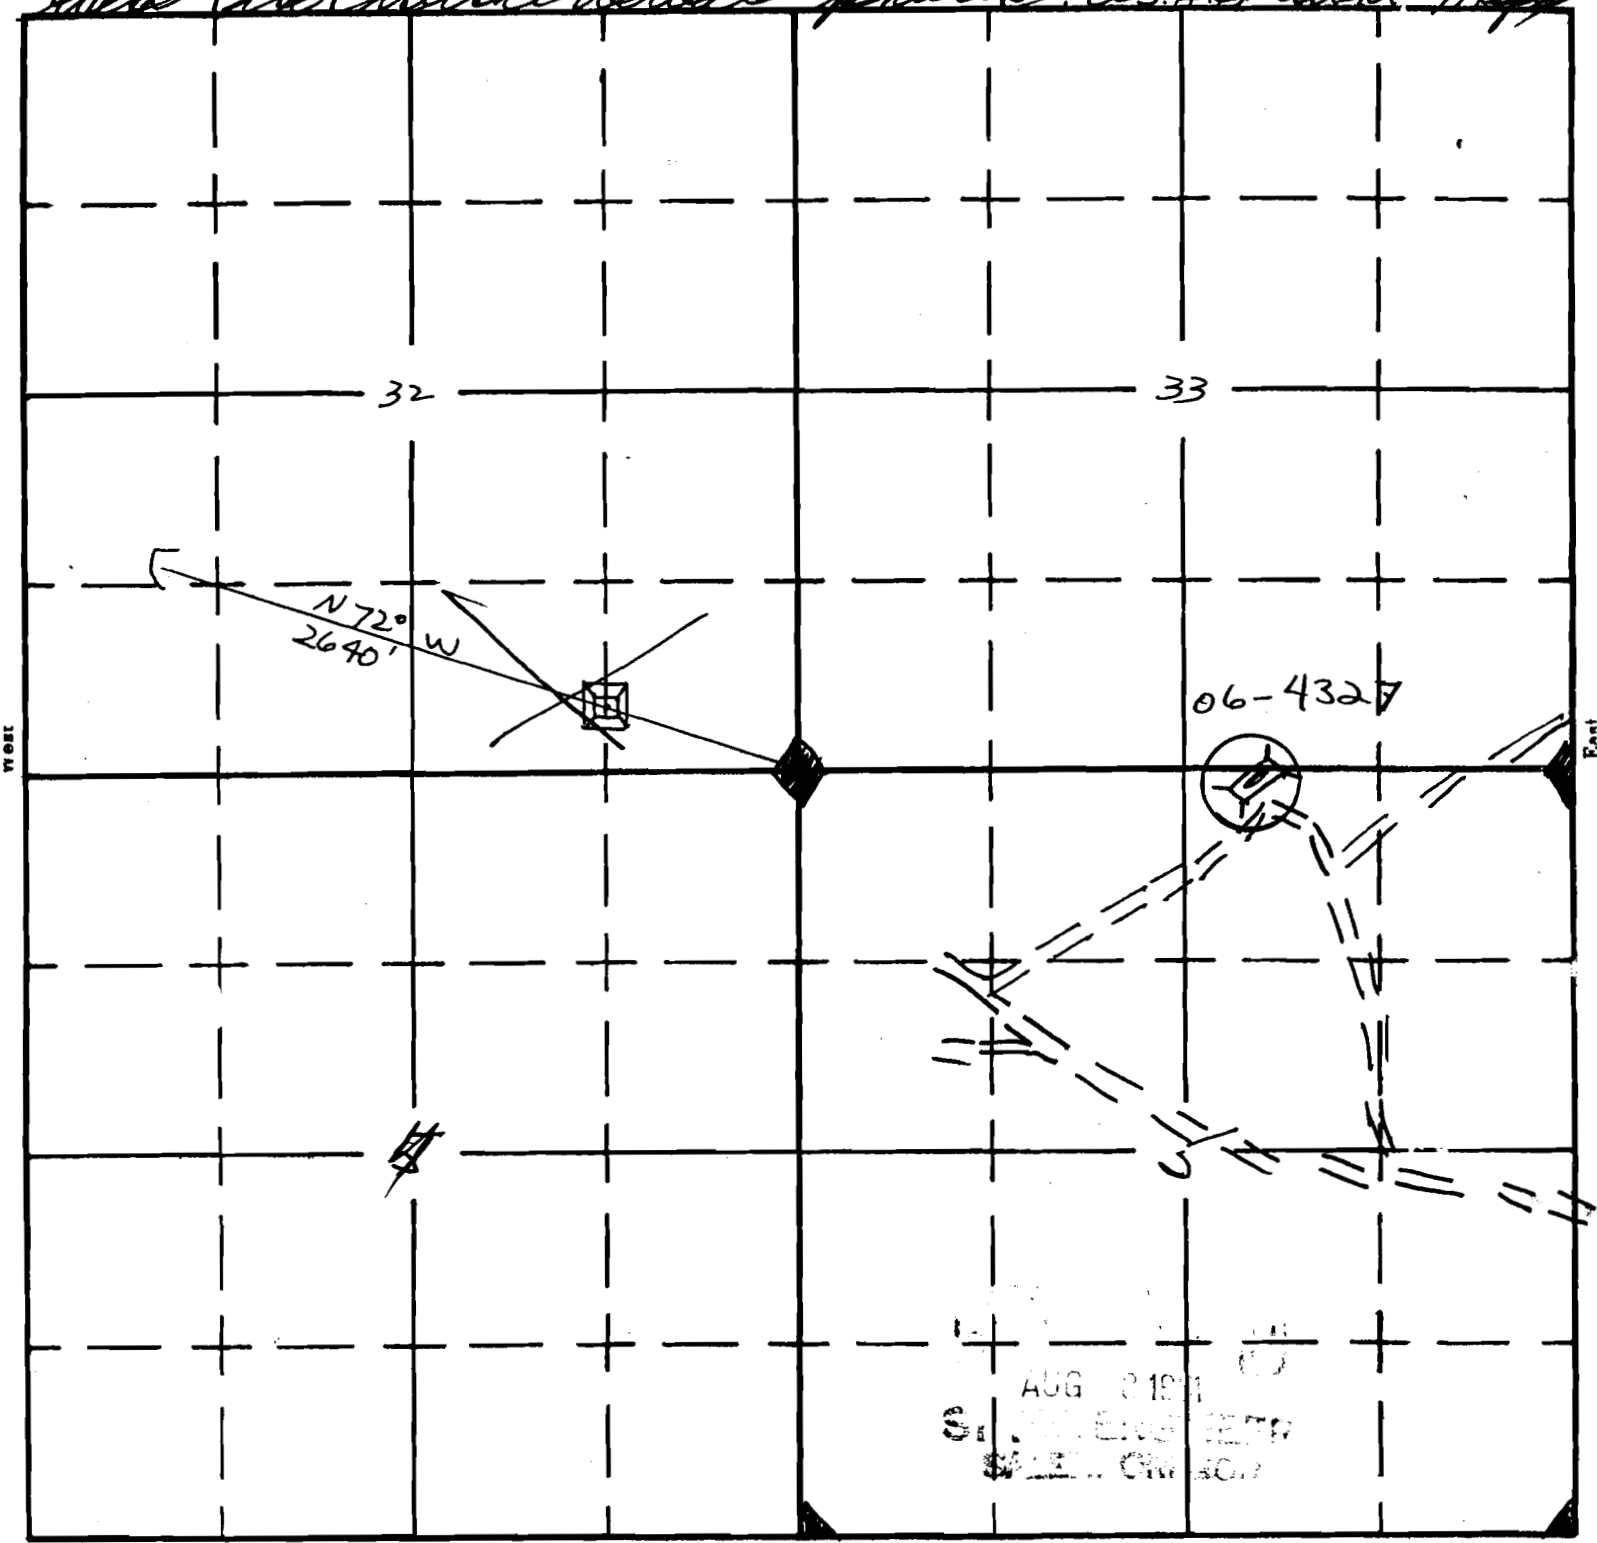

AUG 2 1987
SALEM, OREGON

APPLICATION No R-36375
PERMIT No. R-4097