


SECTION

8

NE 1/4 NE 1/4

TOWNSHIP 22S, RANGE 27E....., W. M.

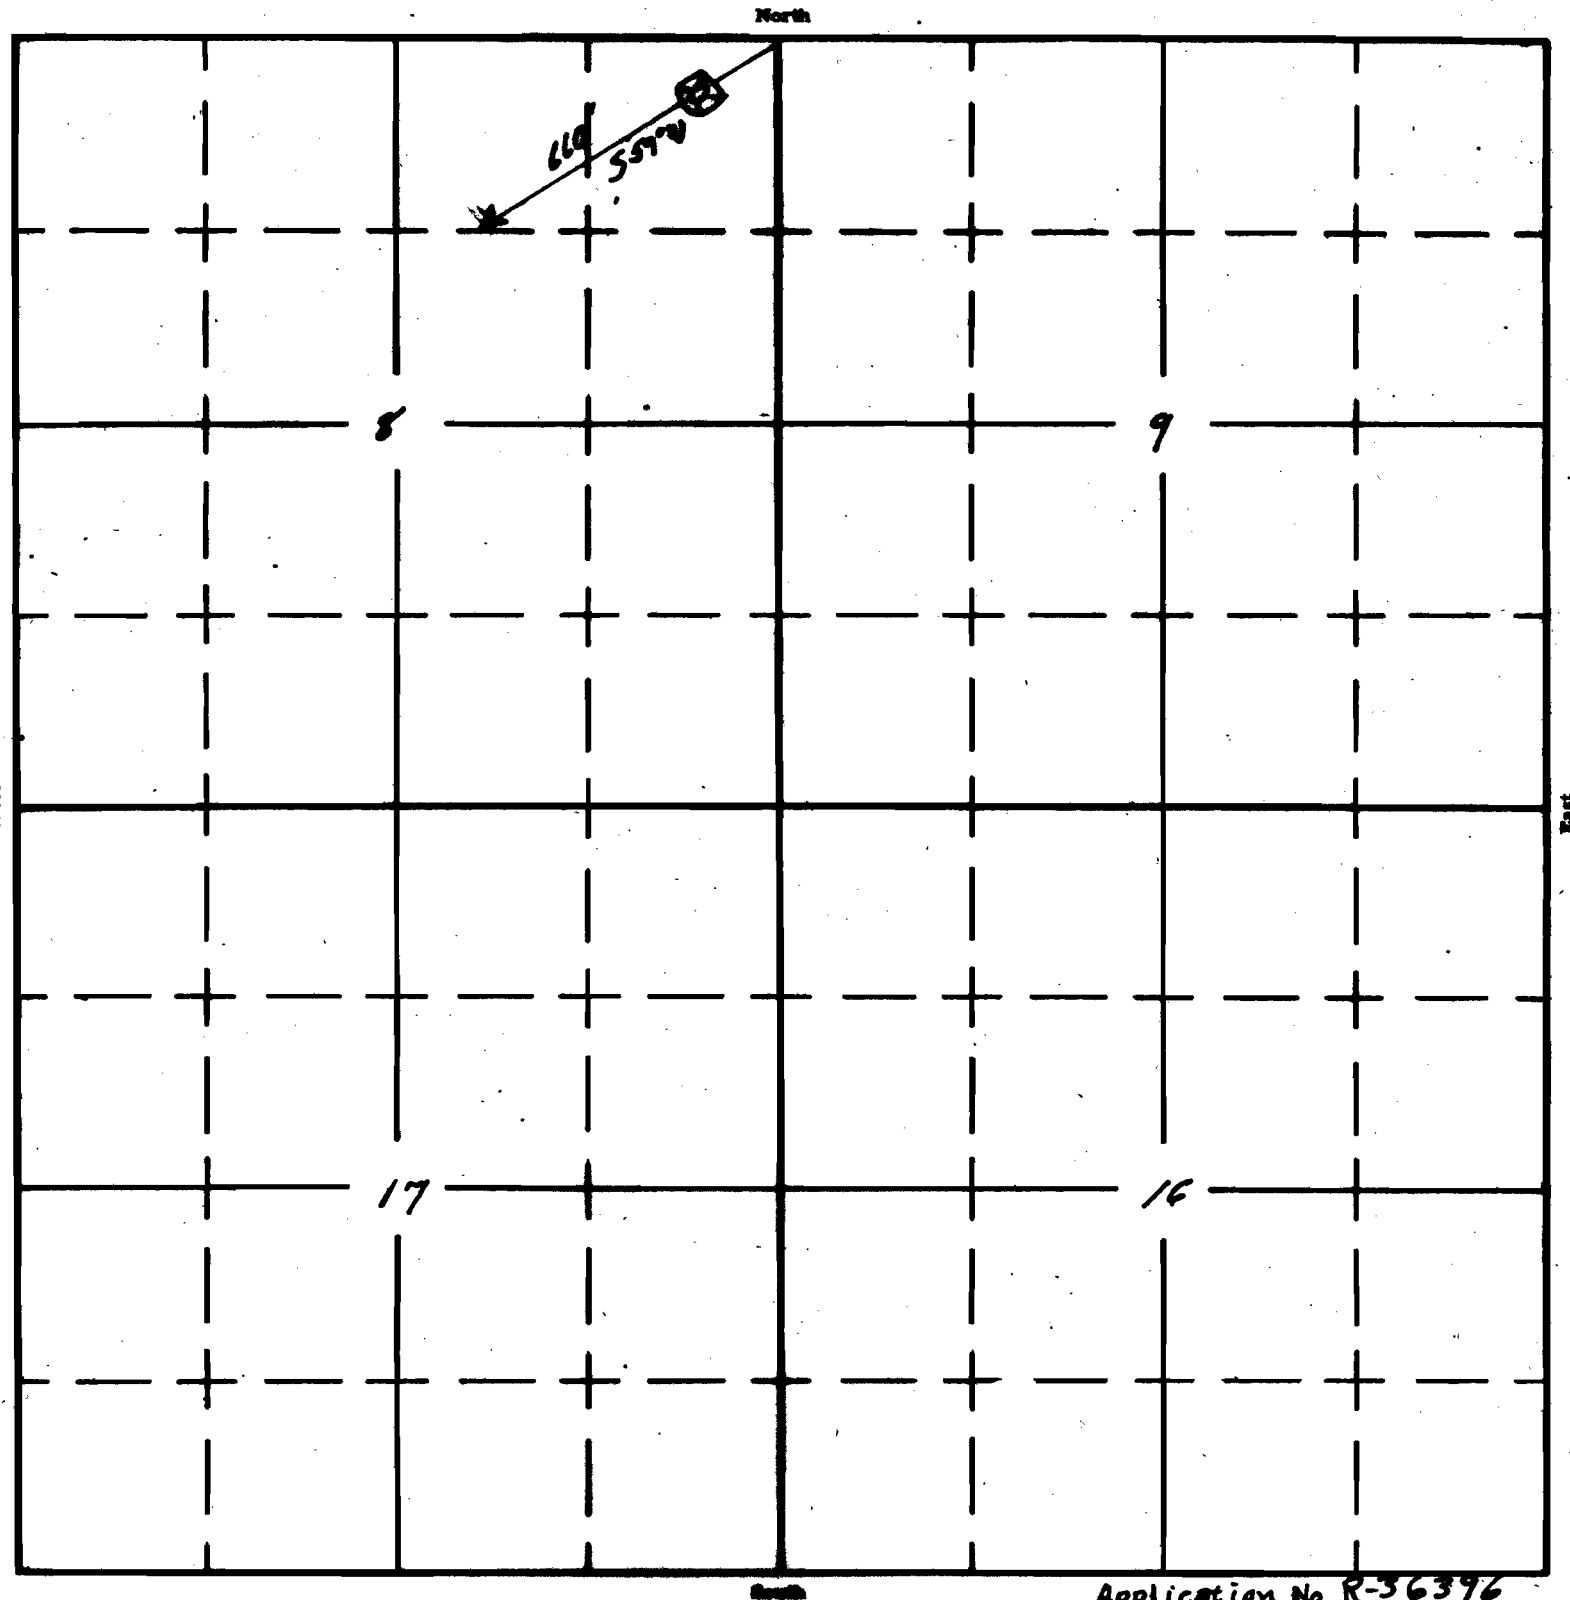

Application No. R-36396
Permit No. R-4098