


SECTION

19
NE 1/4 NE 1/4

TOWNSHIP21S, RANGE 29E....., W. M.

North

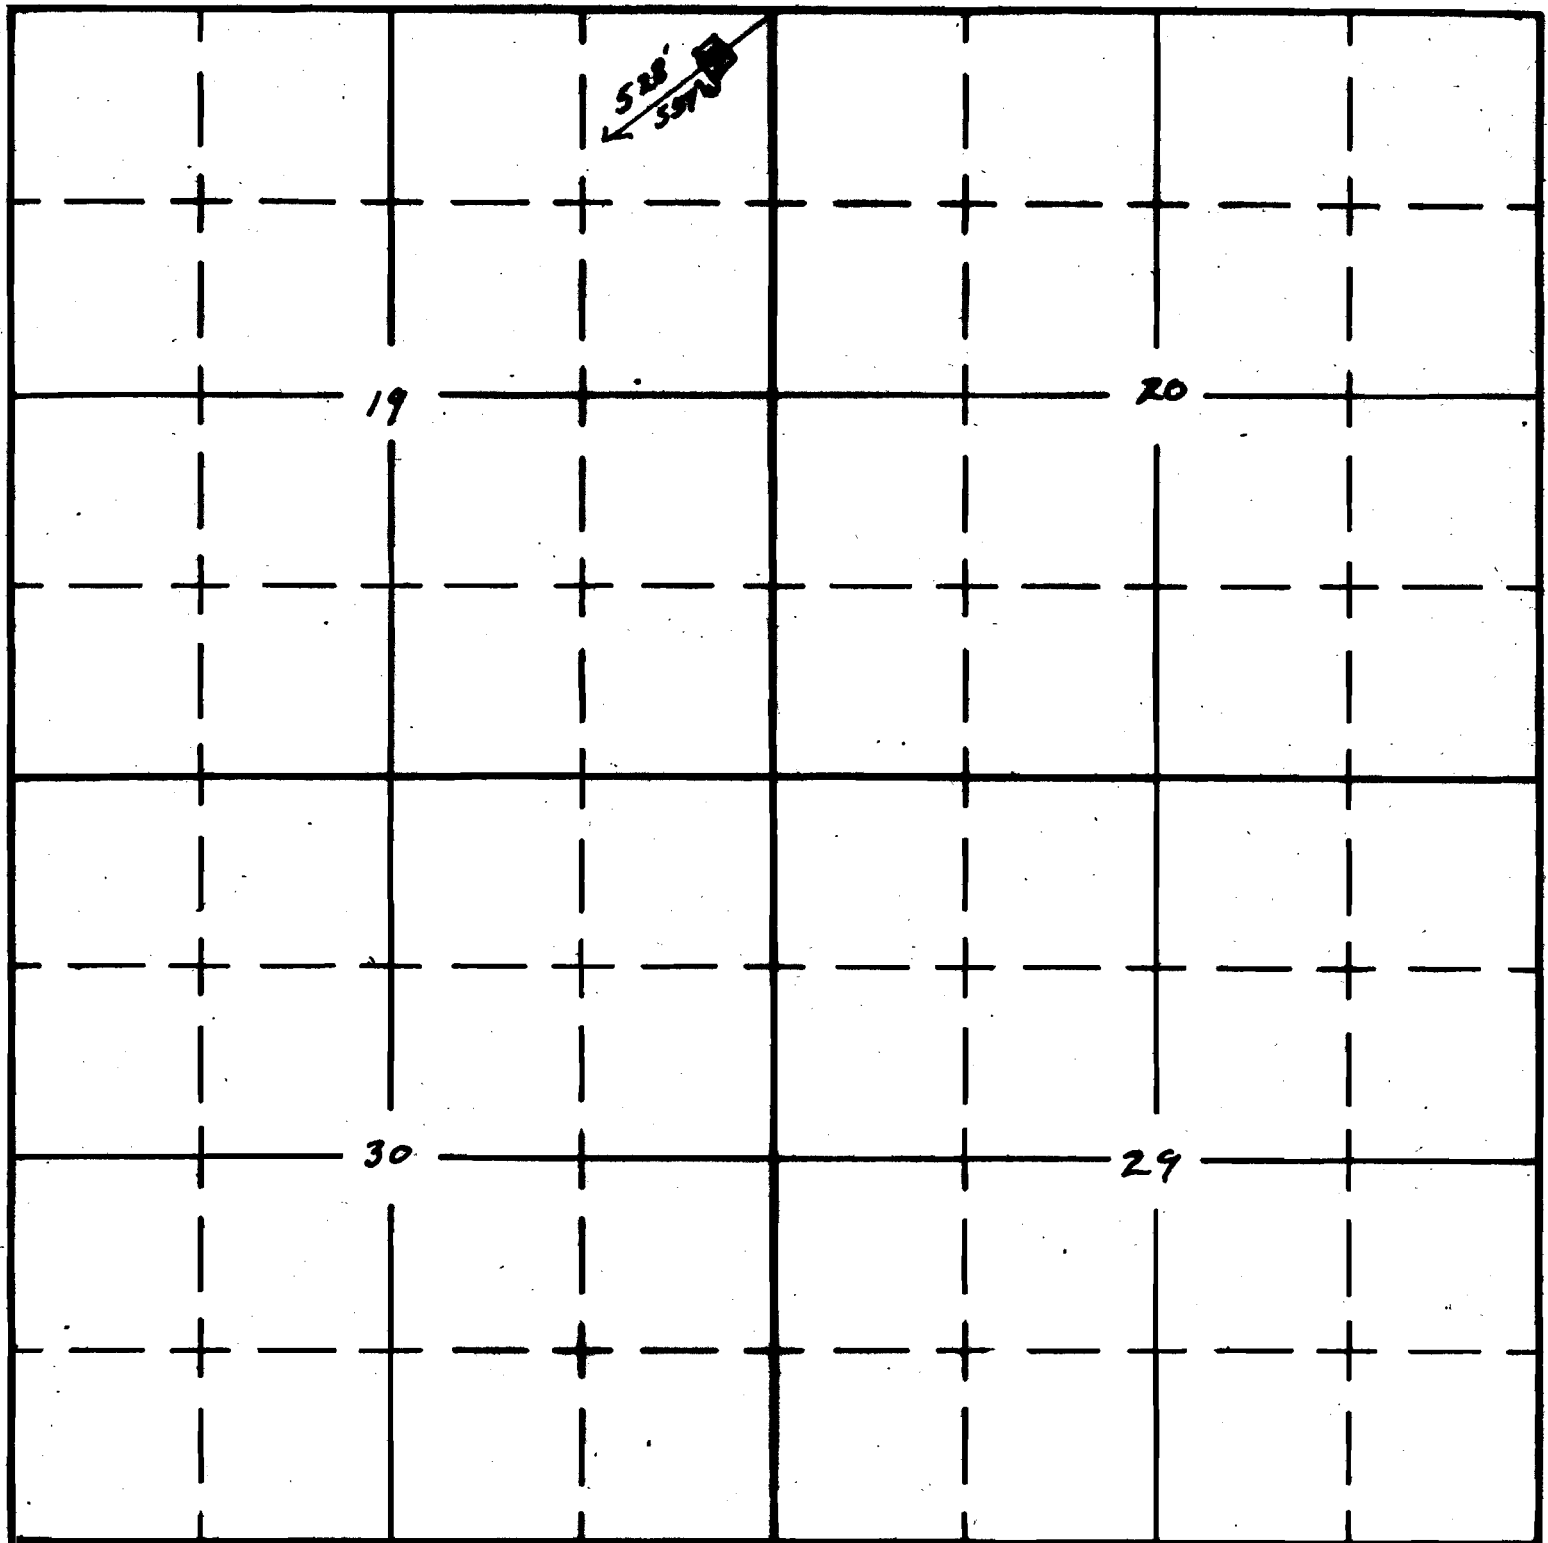

South

Application No. R-36400
Permit No. R-4100