


Form AI-187
March 1961

UNITED STATES
DEPARTMENT OF THE INTERIOR
BUREAU OF LAND MANAGEMENT

SECTION 5

Oregon State Water Filings

SE 1/4 SW 1/4 TOWNSHIP 40S, RANGE 31E, W. M.

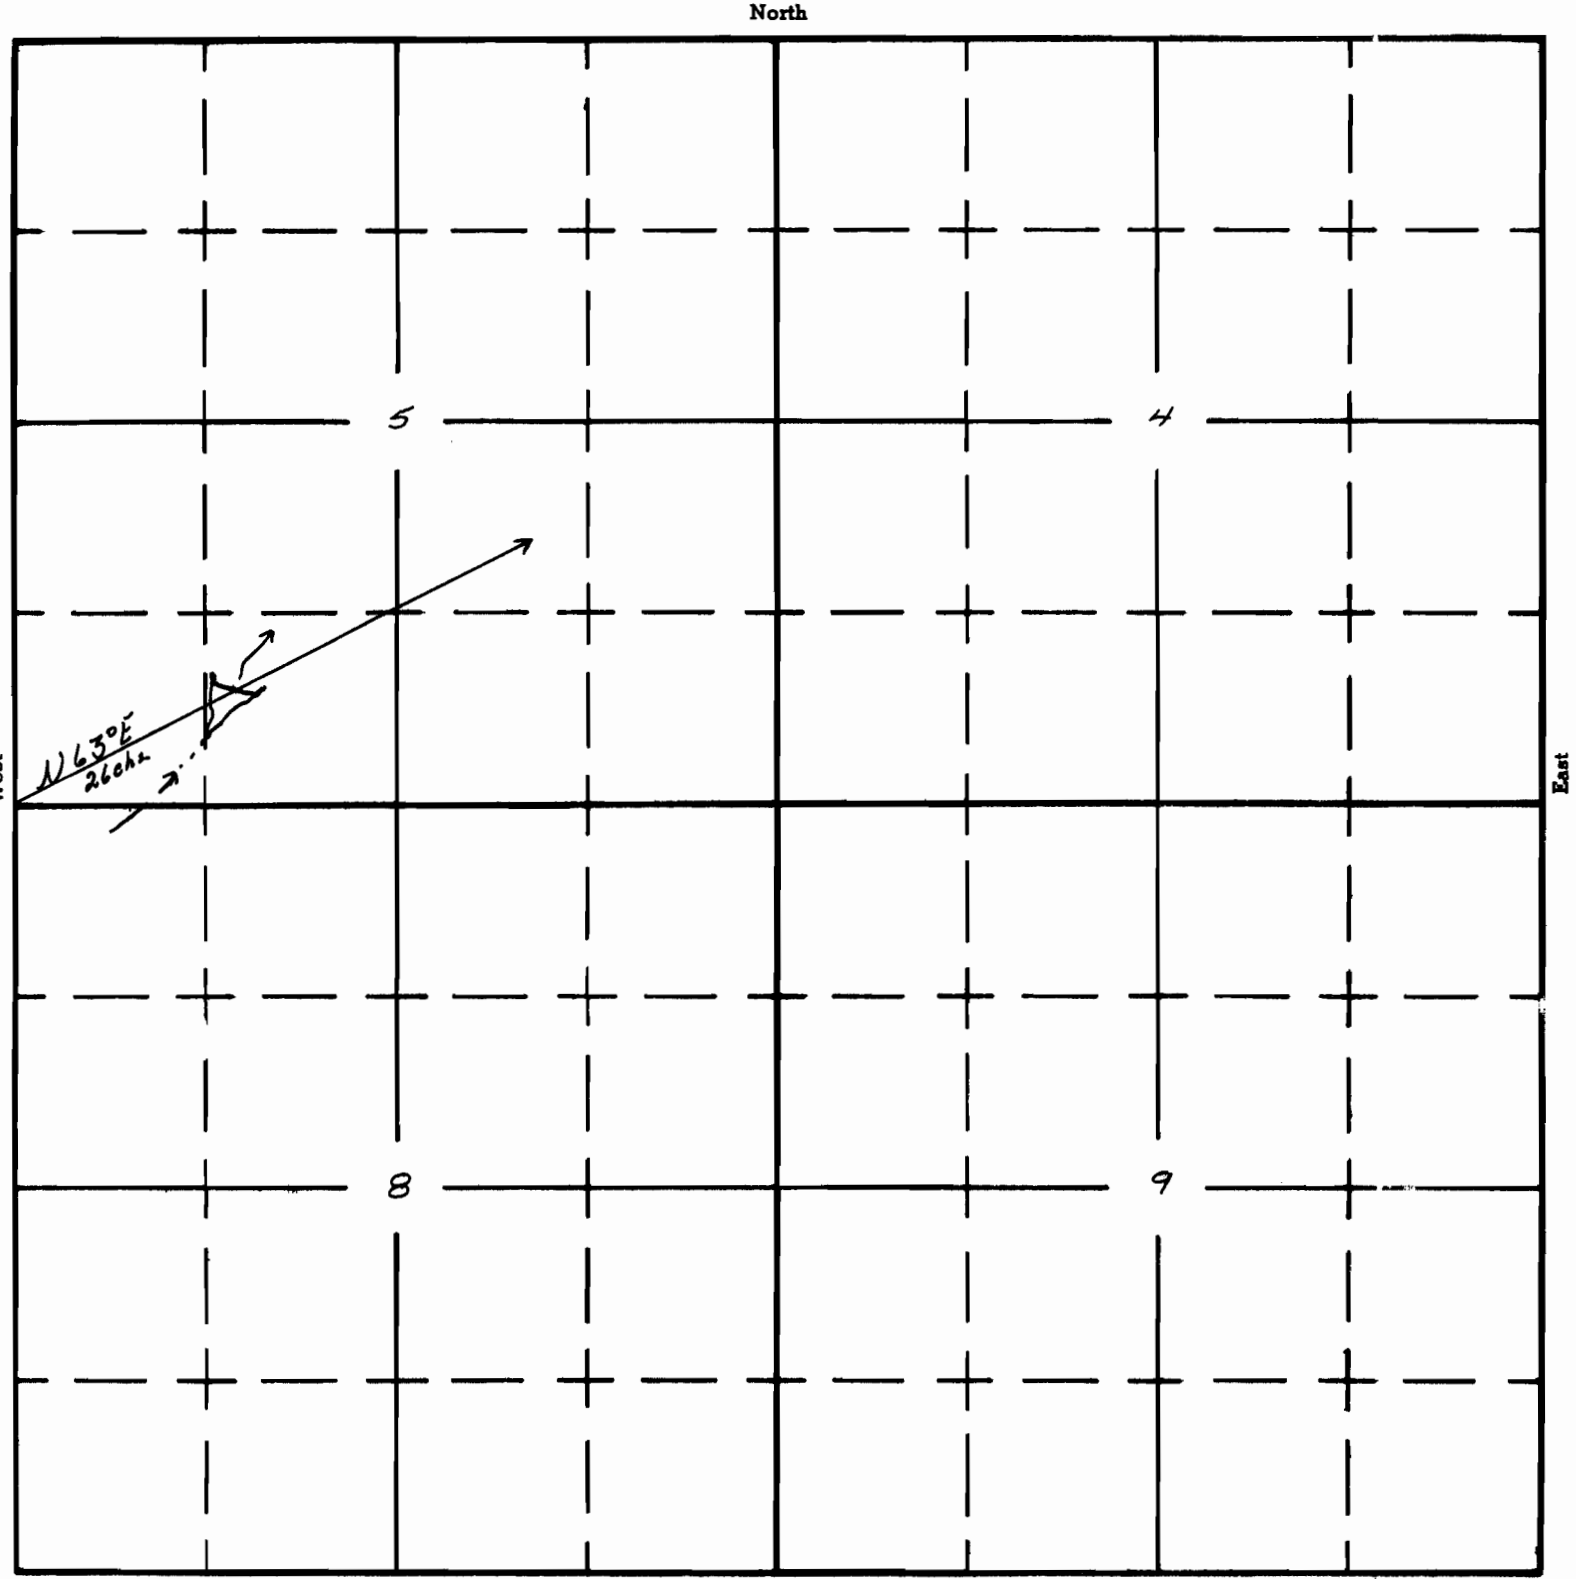

Horn Wh.
0-1-585

APPLICATION No. R-36525
PERMIT No. R-4113