

Form A1-187
March 1961

UNITED STATES
DEPARTMENT OF THE INTERIOR
BUREAU OF LAND MANAGEMENT


SECTION

19

Oregon State Water Filings

NE 1/4 NE 1/4

TOWNSHIP 40S, RANGE 31E, W. M.

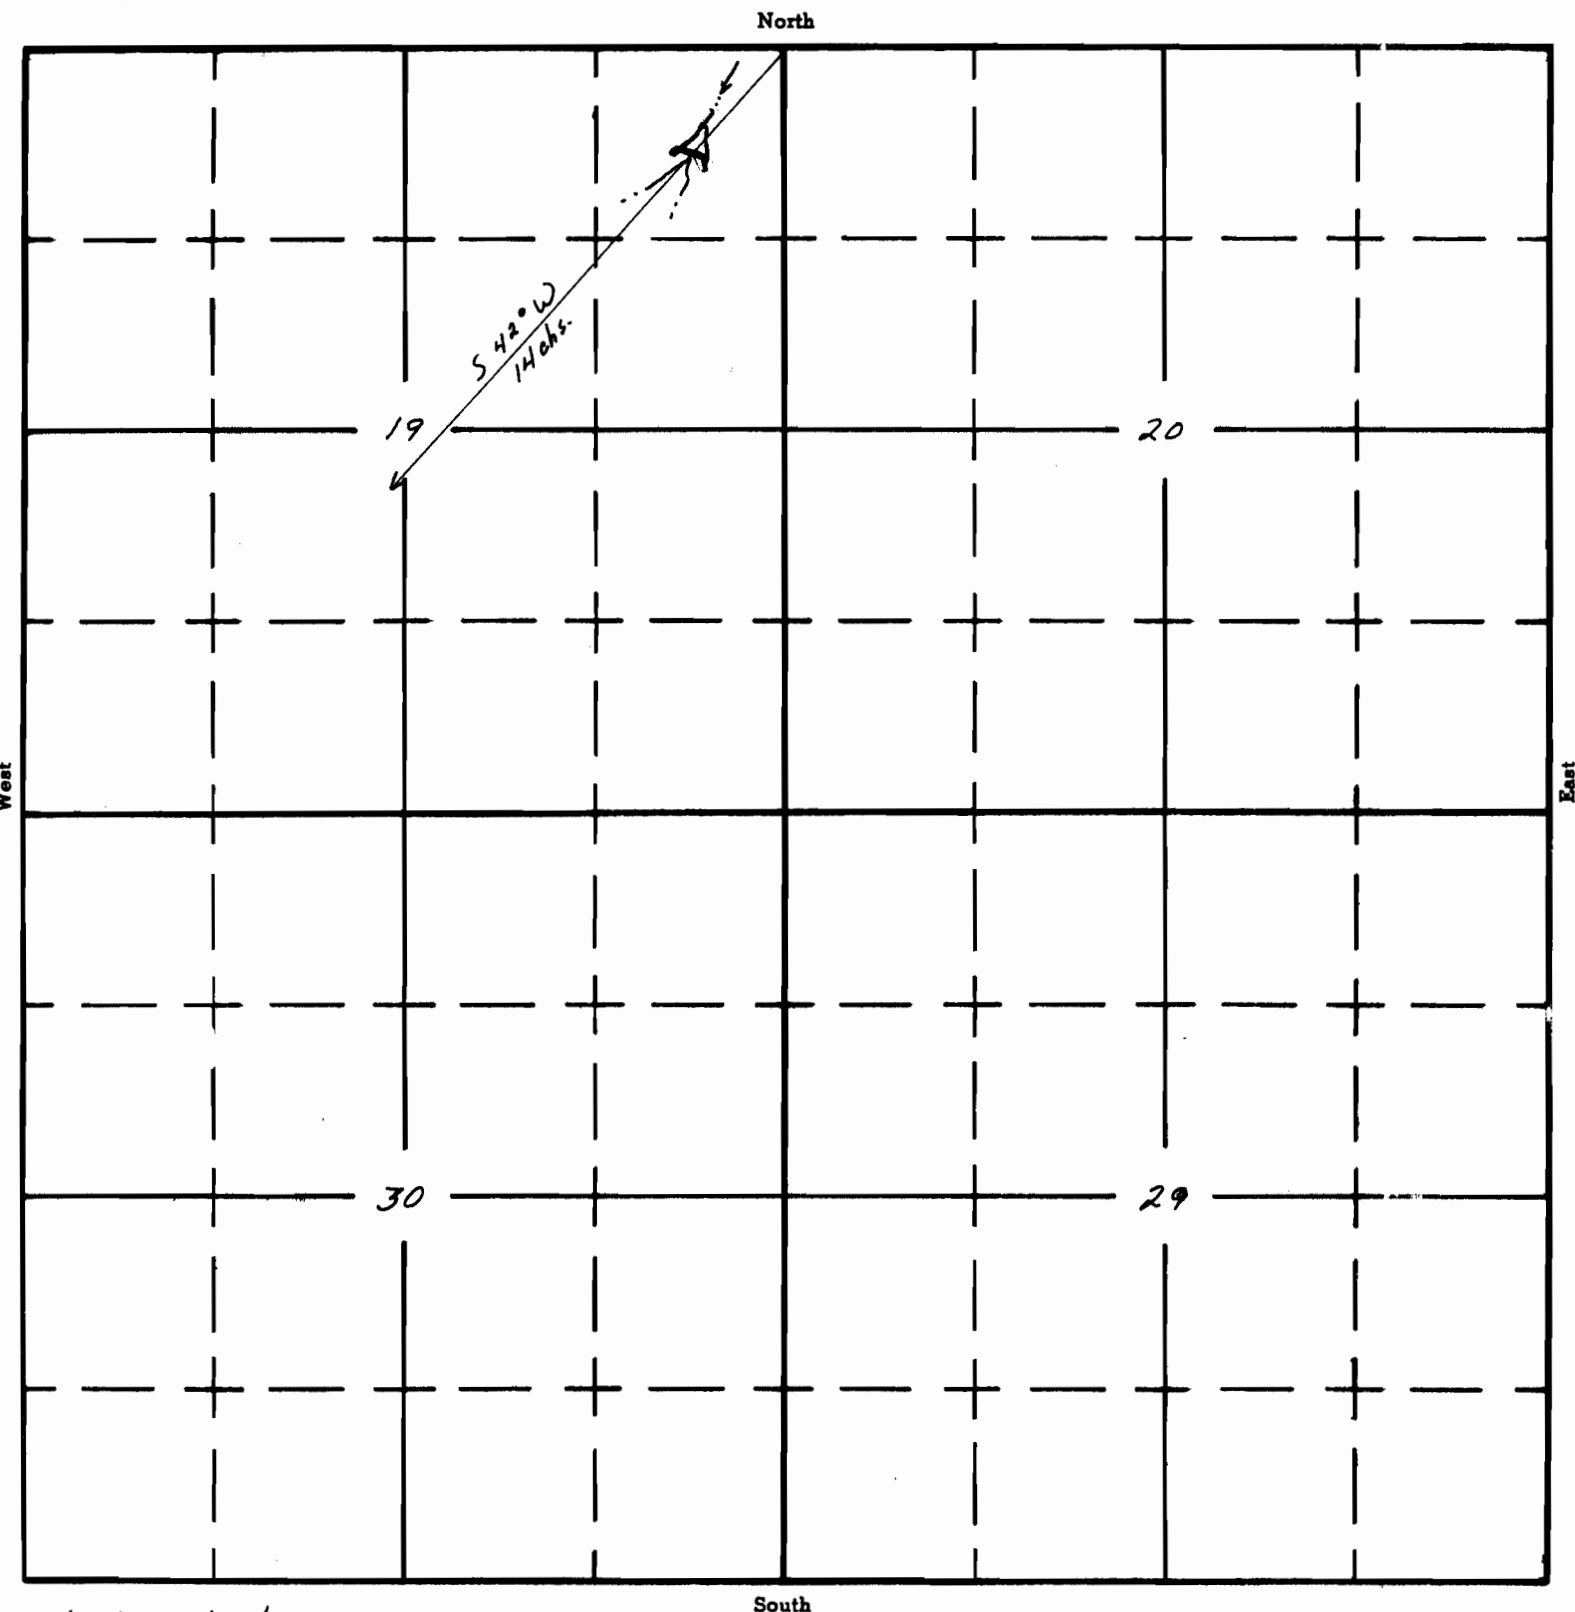

Lone Jack Wh.
0-1-5B3A

APPLICATION No. R-36546
PERMIT No. R-4114