


UNITED STATES
DEPARTMENT OF THE INTERIOR
BUREAU OF LAND MANAGEMENT

SECTION 6

Oregon State Water Filings

SW 1/4 SW 1/4 TOWNSHIP 39S, RANGE 27E, W. M.

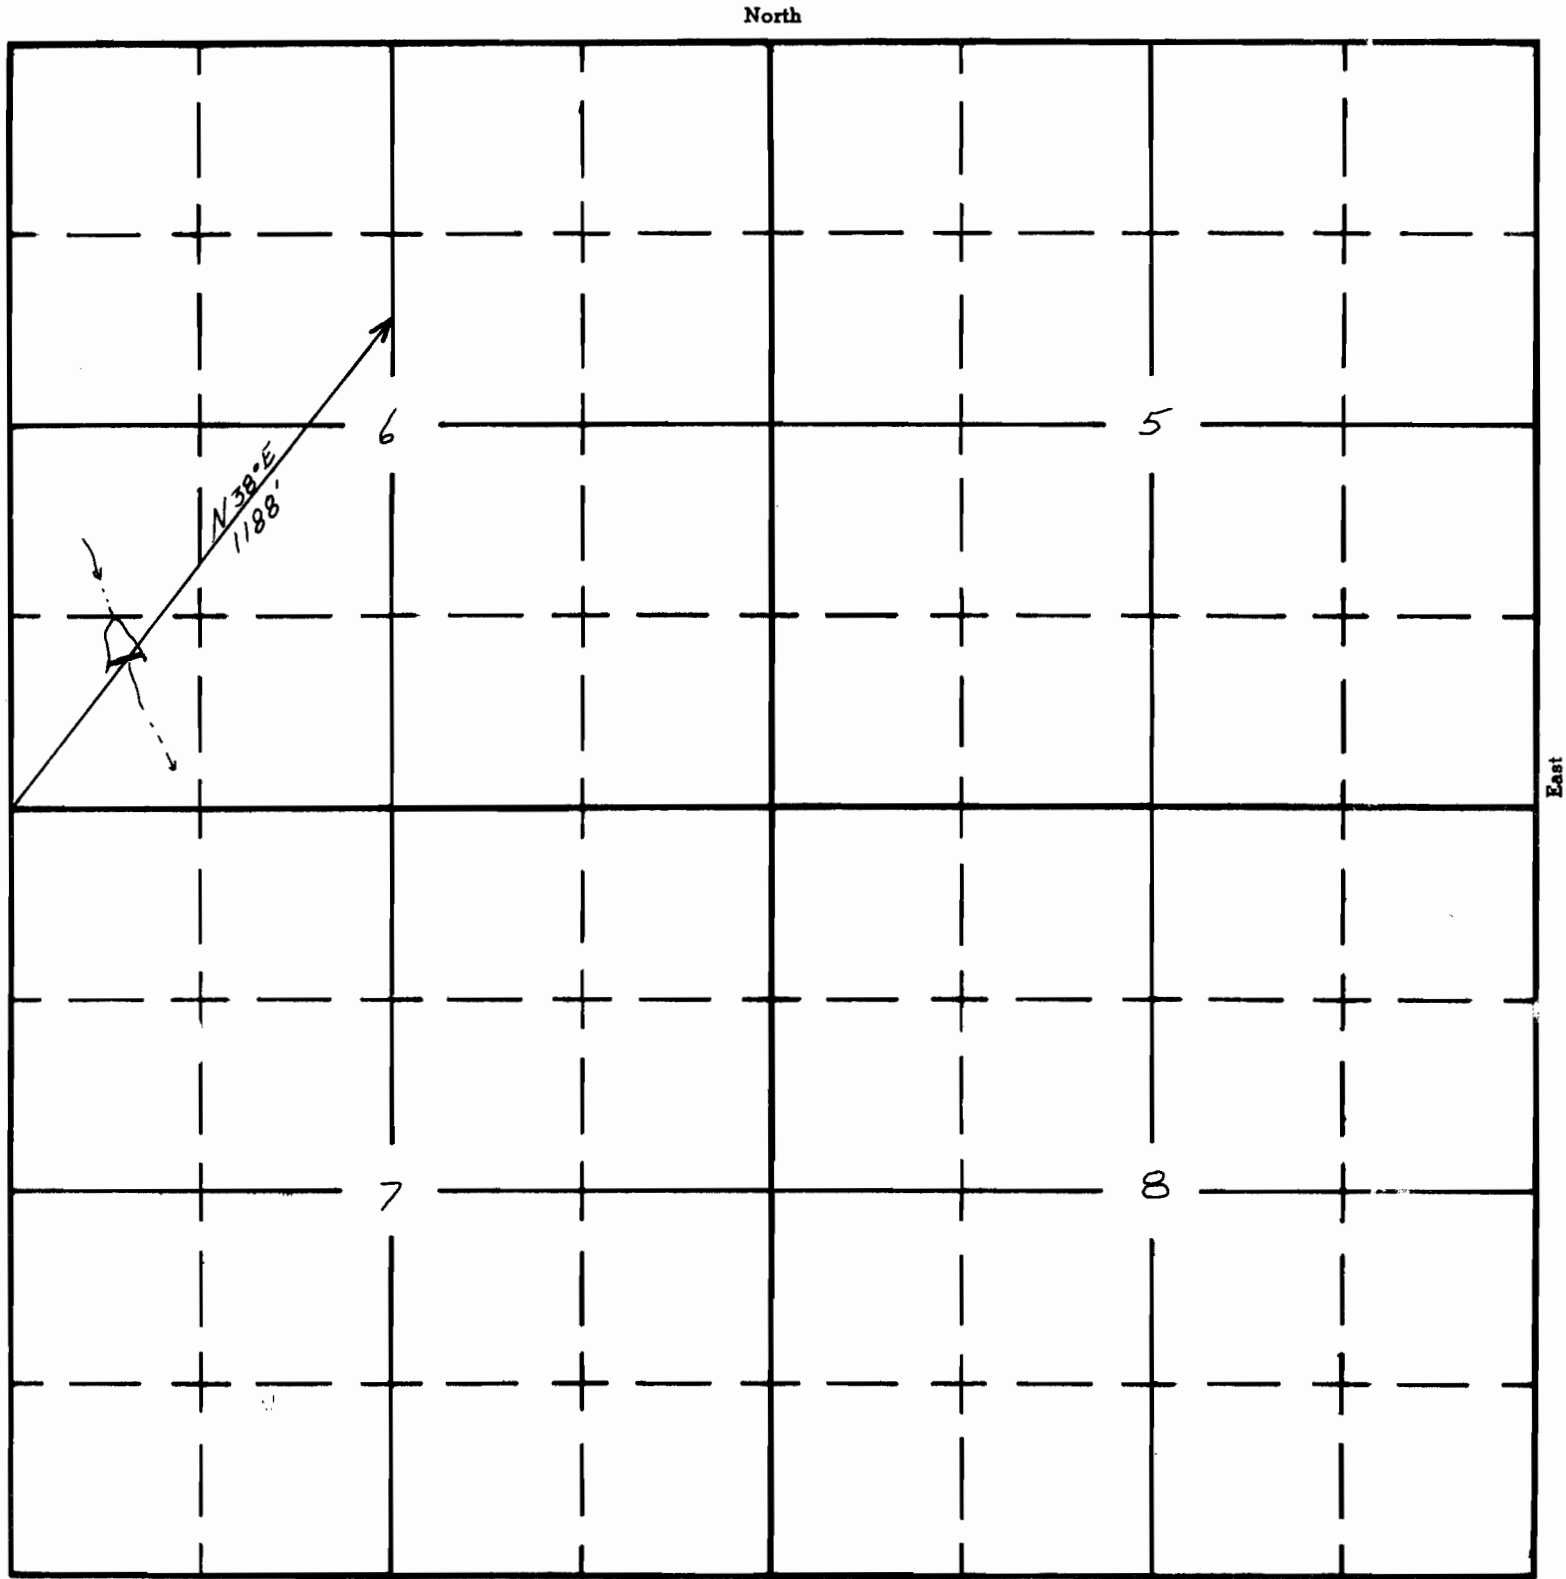

Jack Lake Res.
0-1-736

APPLICATION No. R-36565
PERMIT No. R-4118