

UNITED STATES
DEPARTMENT OF THE INTERIOR
BUREAU OF LAND MANAGEMENT


SECTION 20

Oregon State Water Filings

NE 1/4 SW 1/4

TOWNSHIP 40S, RANGE 30E, W. M.

North

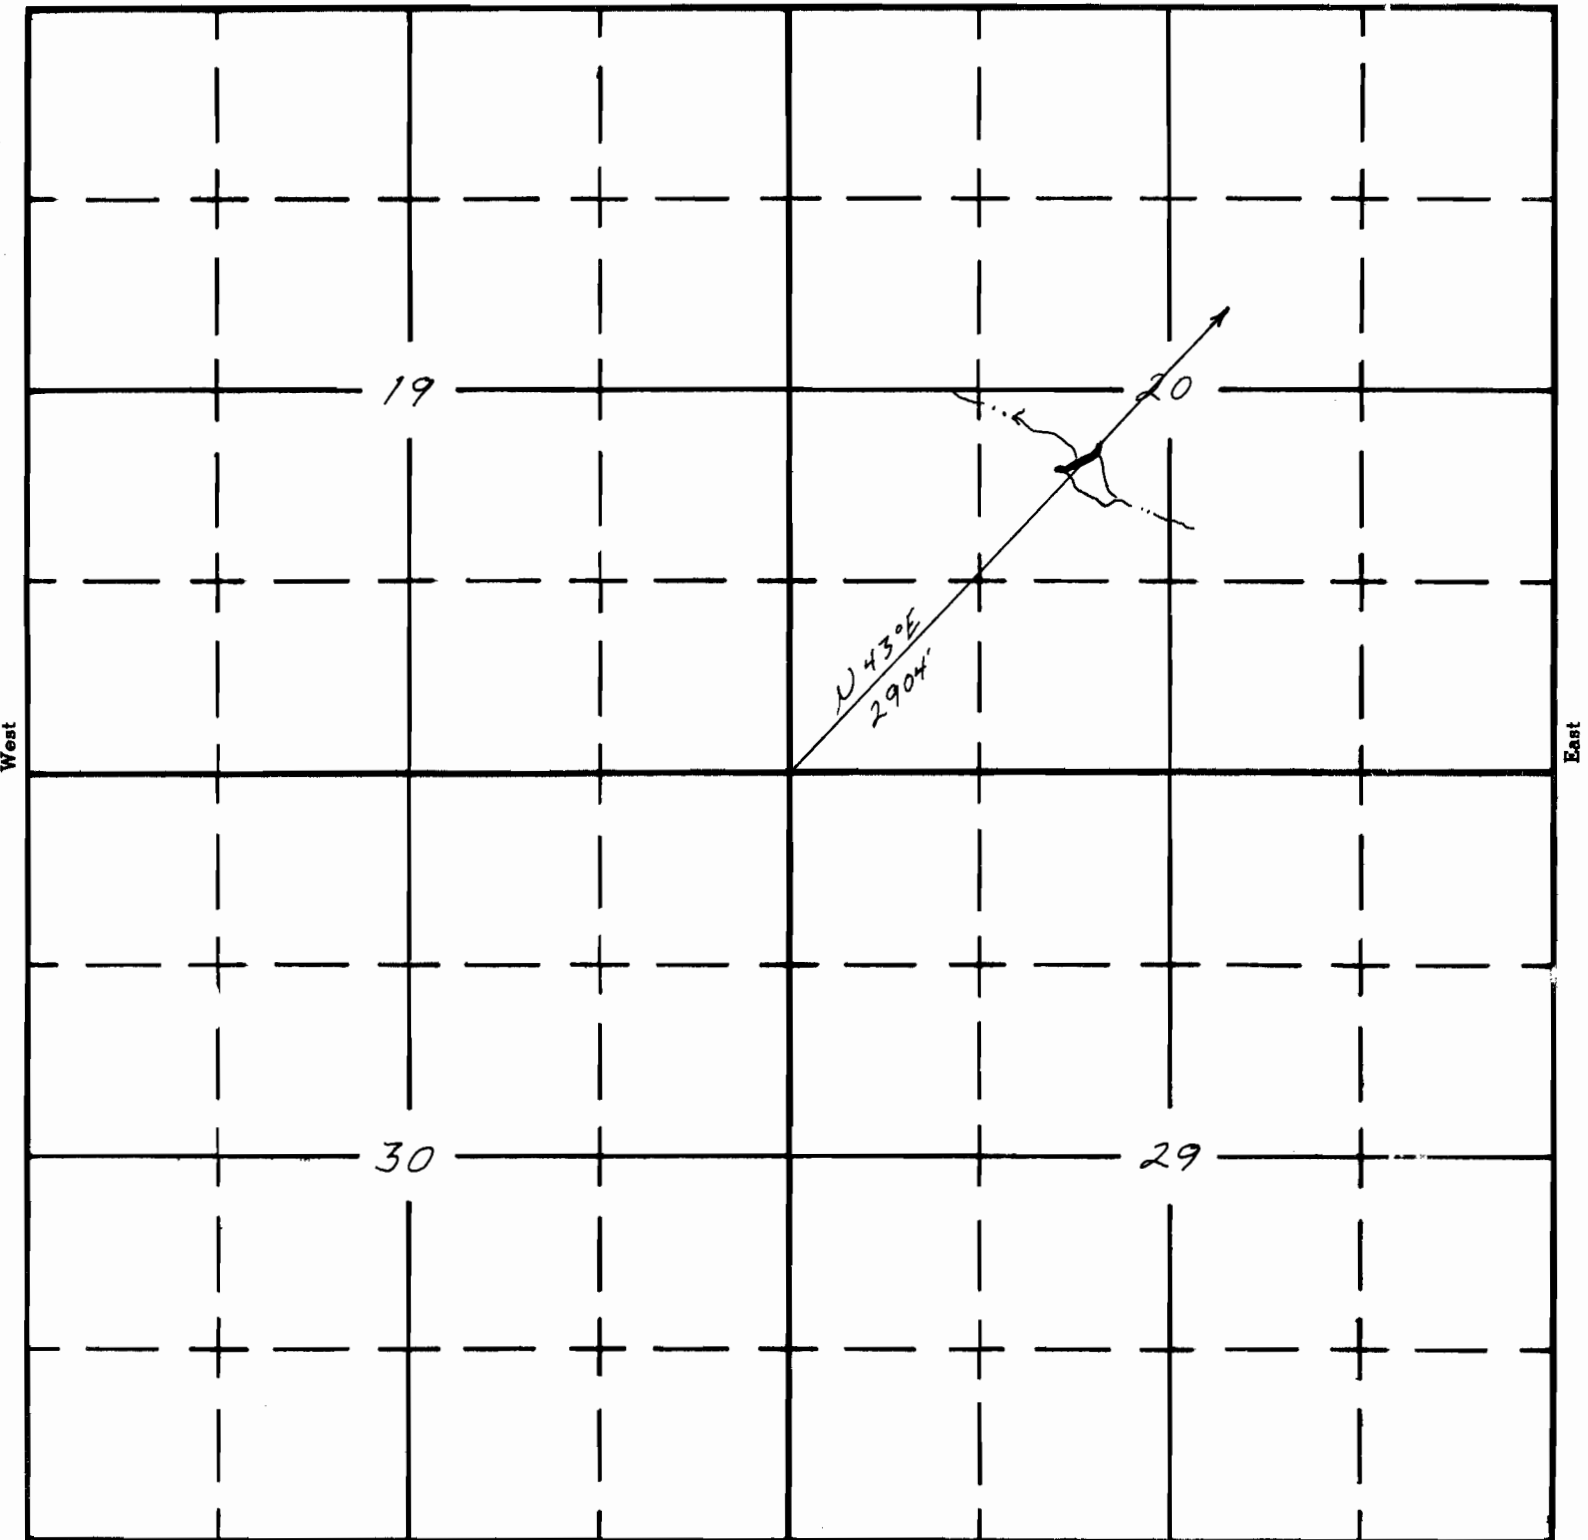

West

East

South

Halfway Res.
0-1-738

APPLICATION No. R-36566
PERMIT No. R-4119