Form A1-187
March 1961

UNITED STATES
DEPARTMENT OF THE INTERIOR
BUREAU OF LAND MANAGEMENT

SECTION 29

SW¼ NW¼

Oregon State Water Filings

TOWNSHIP 37S, RANGE 29E, W. M.

TIED IN WITH AERIAL PHOTOS AND O.S.H.D. QUAD MAPS

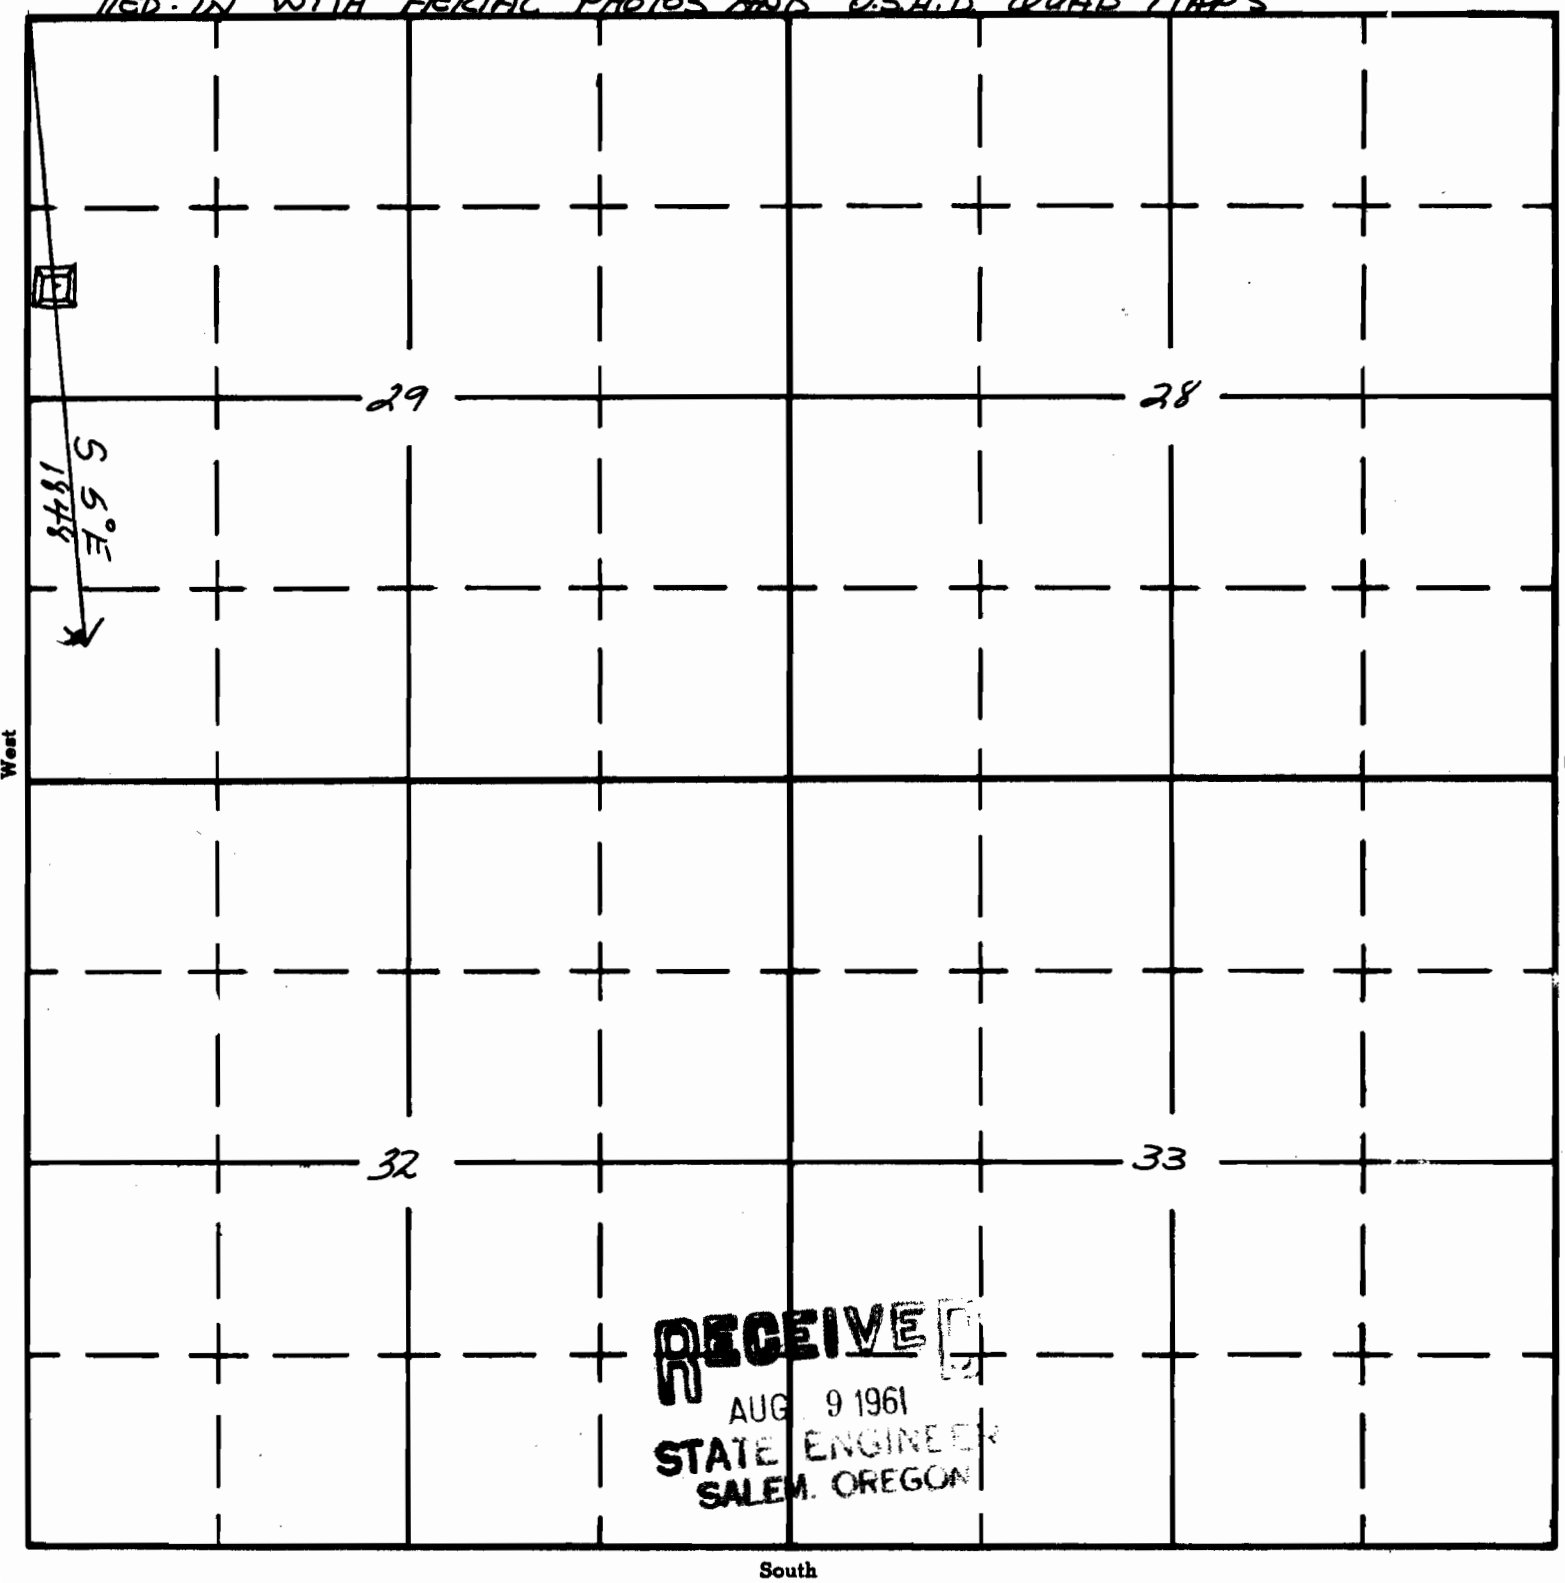

RECEIVED
AUG 9 1961
STATE ENGINEER
SALEM, OREGON

APPLICATION No. R-36945
PERMIT No. R-4121