

UNITED STATES
DEPARTMENT OF THE INTERIOR
BUREAU OF LAND MANAGEMENT


SECTION 19

Oregon State Water Filings

NW 1/4 SE 1/4

TOWNSHIP 37S, RANGE 30E, W. M.

Tied in with aerial photos & O.S.H.D. Quad Maps.

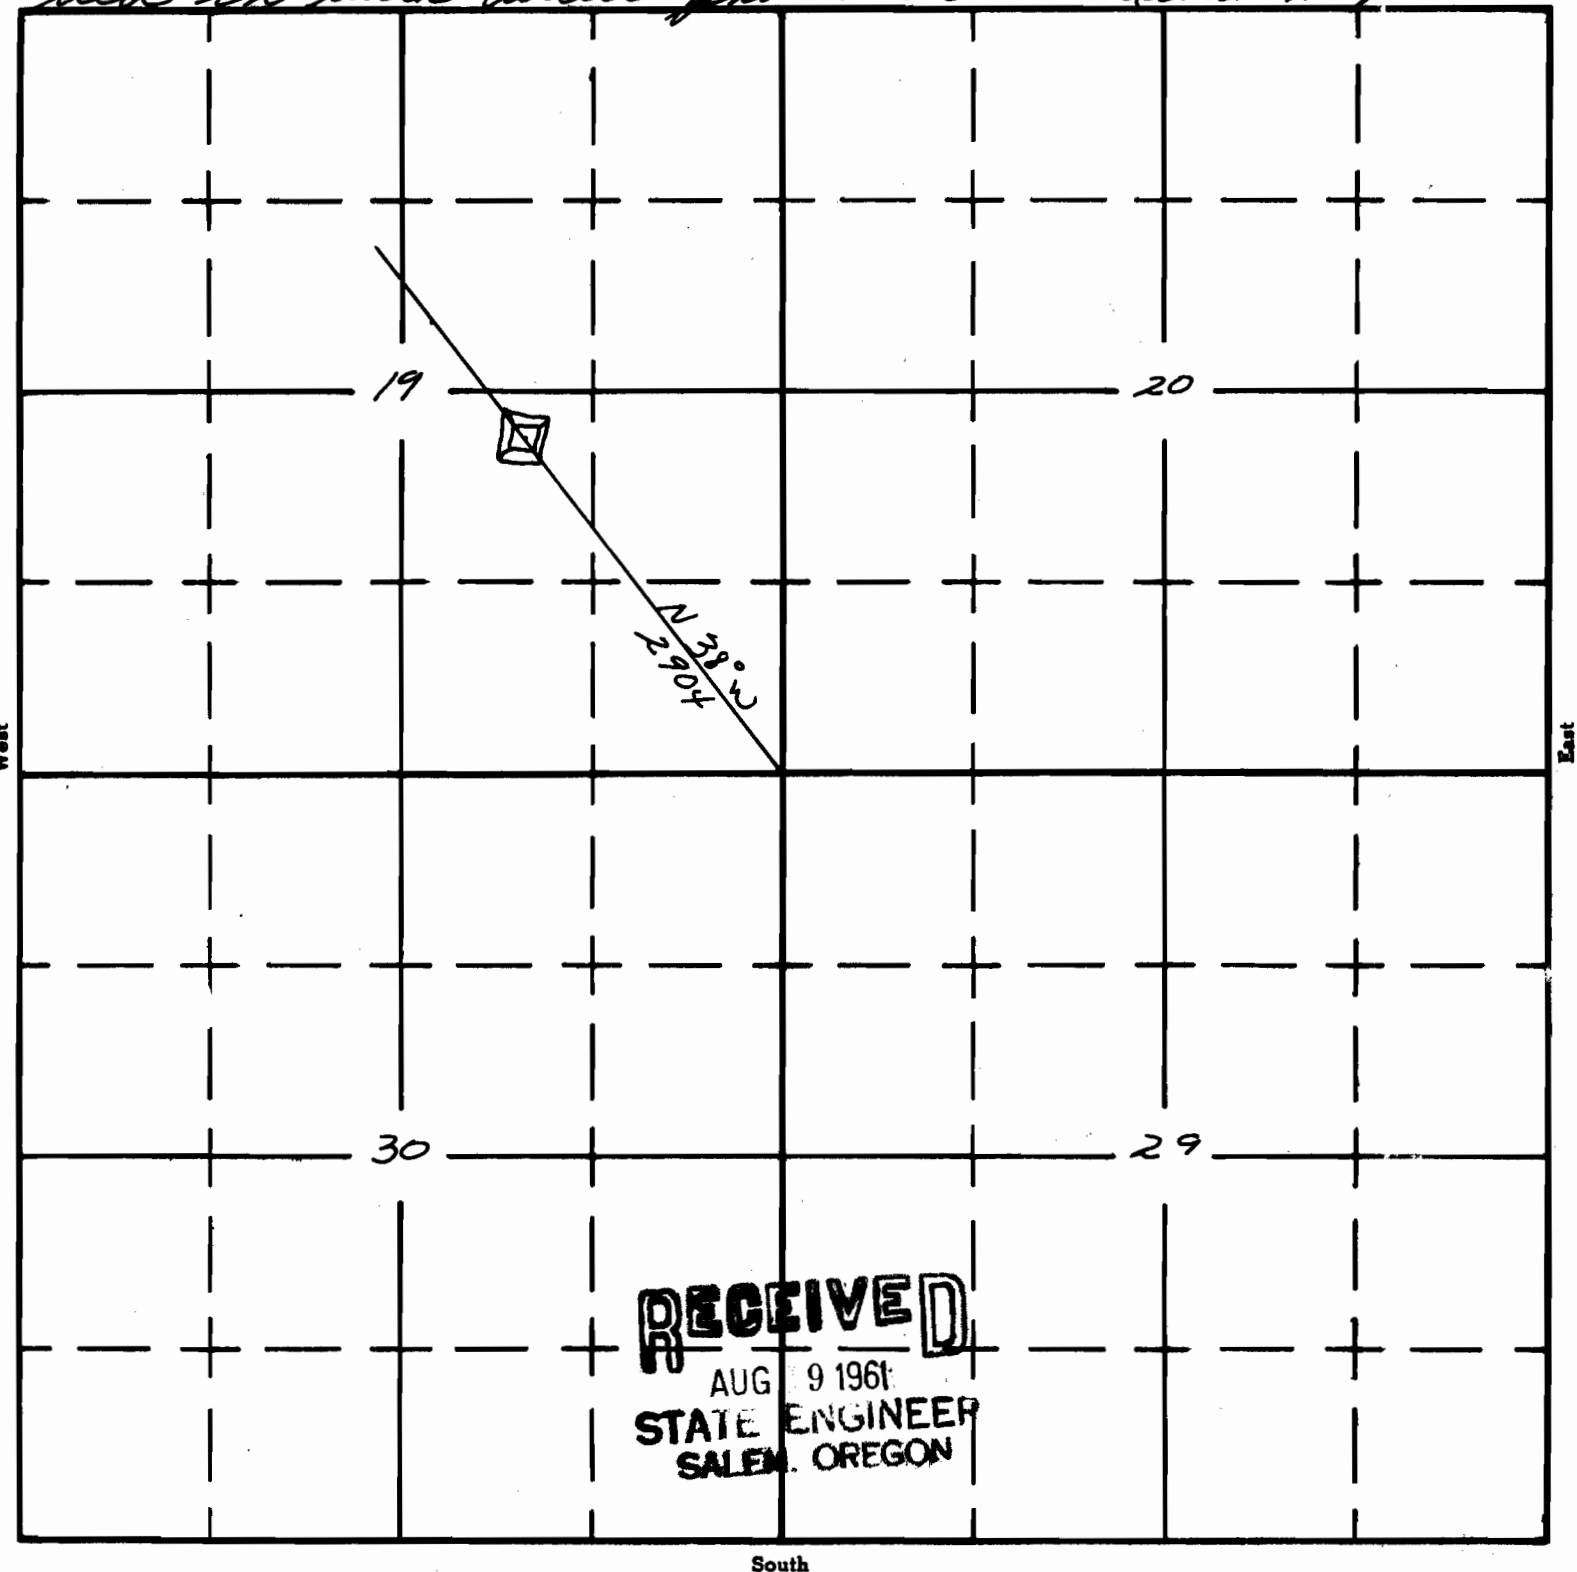

APPLICATION No. R-36947
PERMIT No. A-4122