

Form 41-187
March 1961

UNITED STATES
DEPARTMENT OF THE INTERIOR
BUREAU OF LAND MANAGEMENT


SECTION 3

Oregon State Water Filings

SE 1/4 NE 1/4

TOWNSHIP 38S, RANGE 26E, W. M.

TIED-IN WITH AERIAL PHOTOS AND O.S.H.D. QUAD MAPS

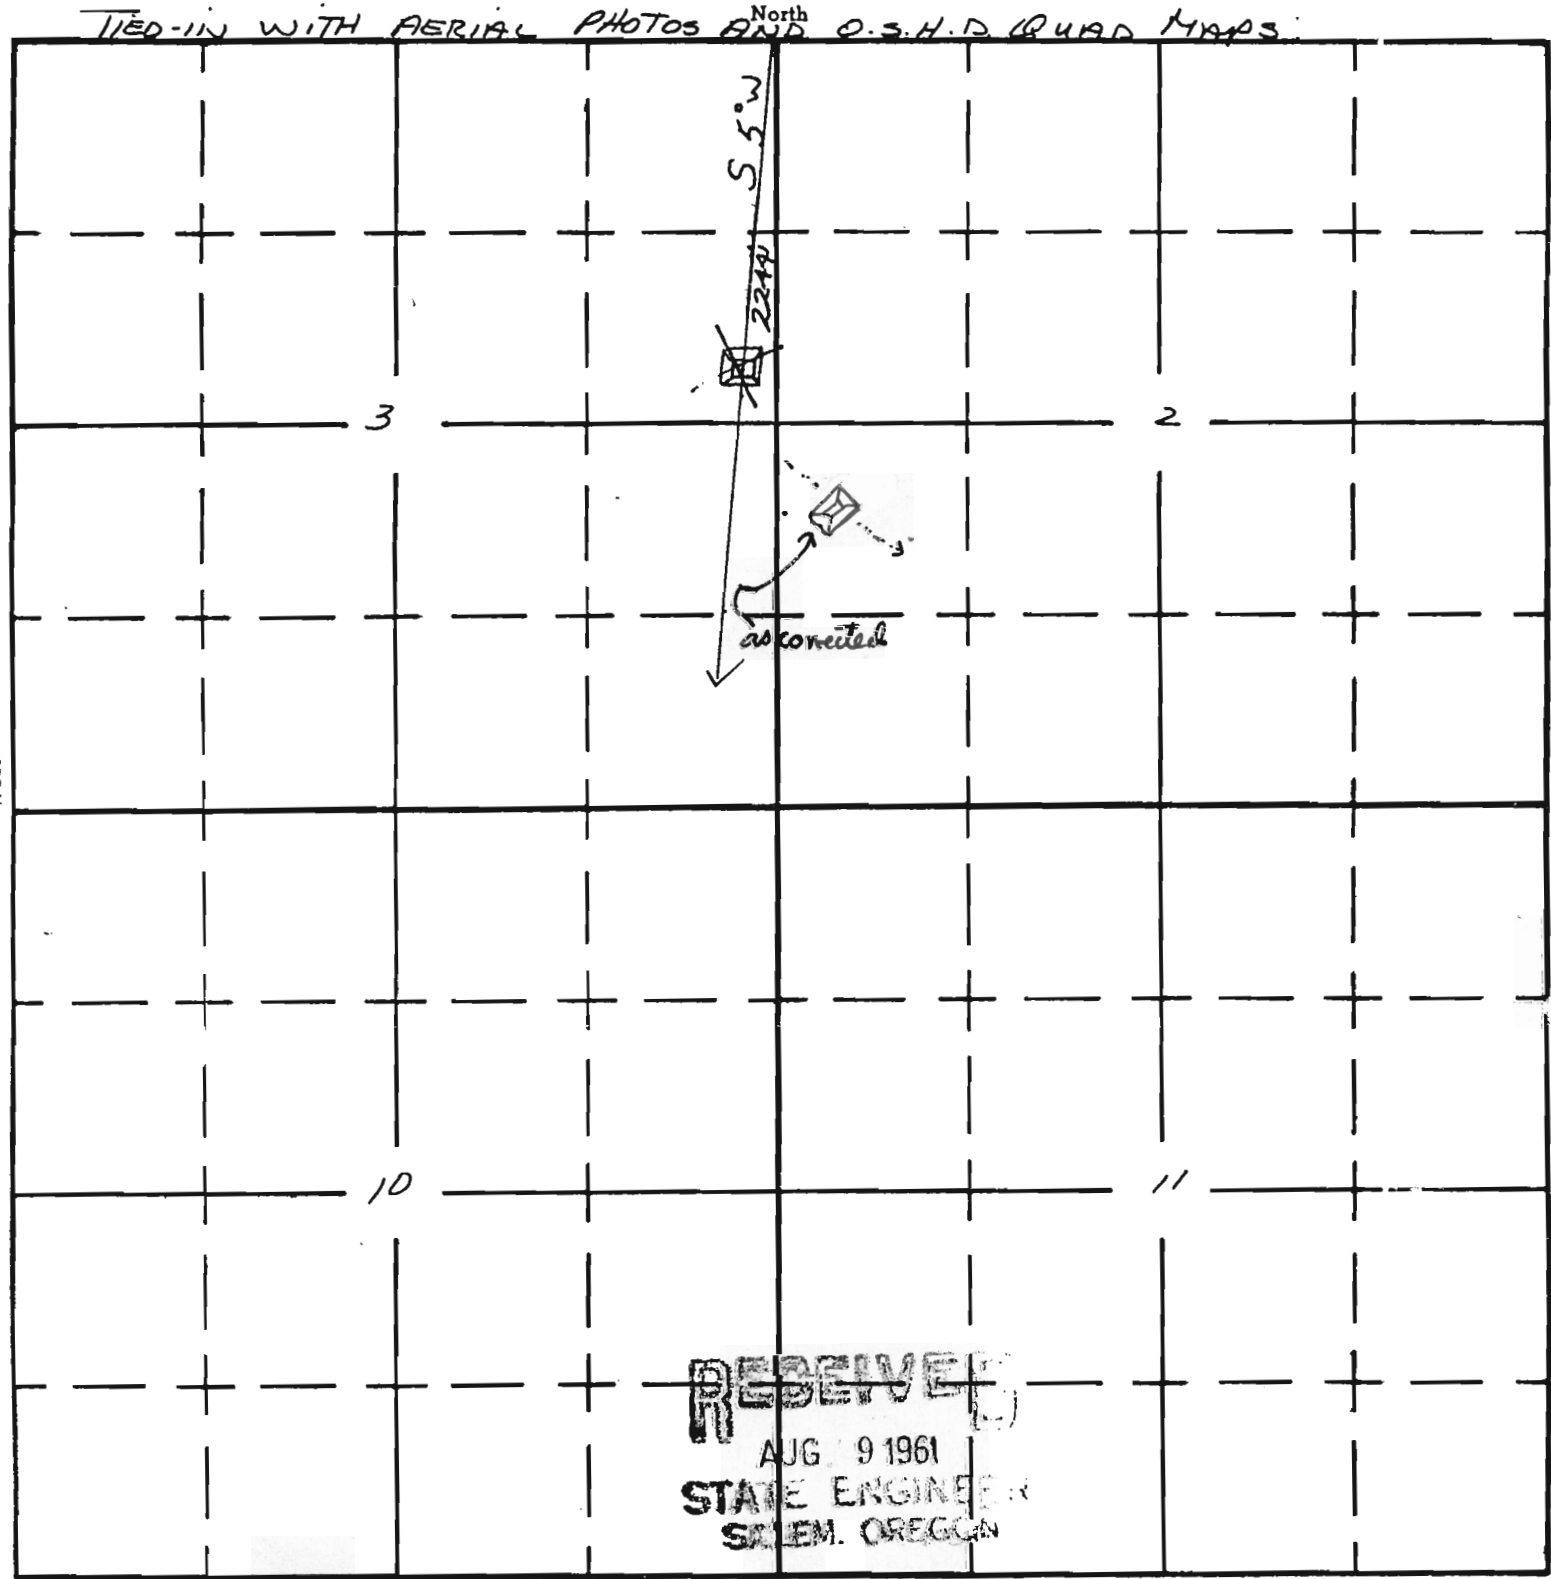

2040 ft North & 520' East of ^{South} the SW corner of Sec. 2.

APPLICATION No. R-36948
PERMIT No. R-4123

Form AI-187
March 1961

UNITED STATES
DEPARTMENT OF THE INTERIOR
BUREAU OF LAND MANAGEMENT


SECTION 3

Oregon State Water Filings

SE 1/4 NE 1/4

TOWNSHIP 38S, RANGE 26E, W. M.

TIED-IN WITH AERIAL PHOTOS AND O.S.H.D. ROAD MAPS

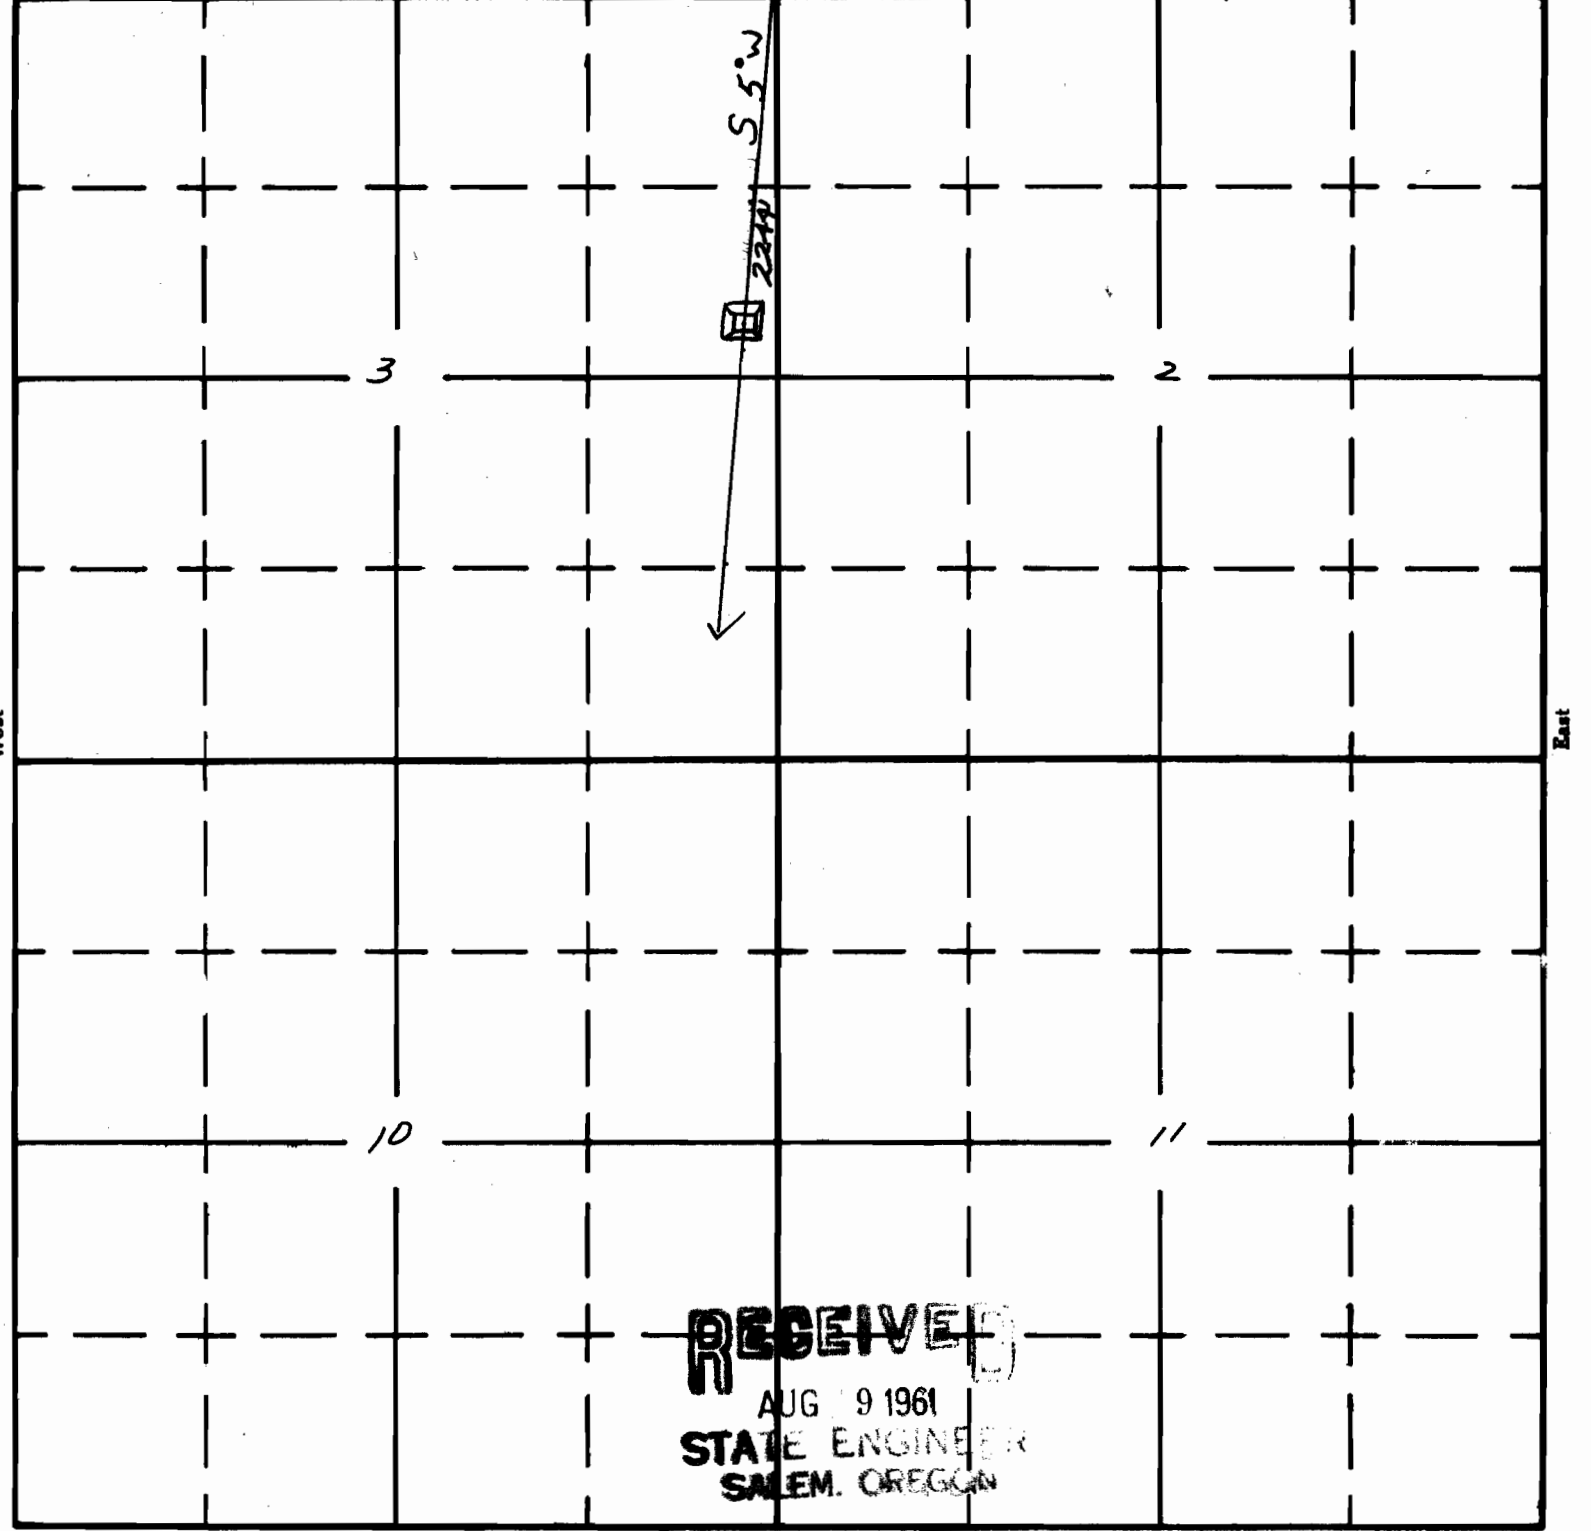

RECEIVED
AUG 19 1961
STATE ENGINEER
SALEM, OREGON

APPLICATION No. R-36948
PERMIT No. R-4123