

UNITED STATES
DEPARTMENT OF THE INTERIOR
BUREAU OF LAND MANAGEMENT


SECTION 23

Oregon State Water Filings

SW 1/4 SE 1/4

TOWNSHIP 40 S, RANGE 31 E, W. M.

Filed in with aerial photos & D.S.H.D. Quad Maps

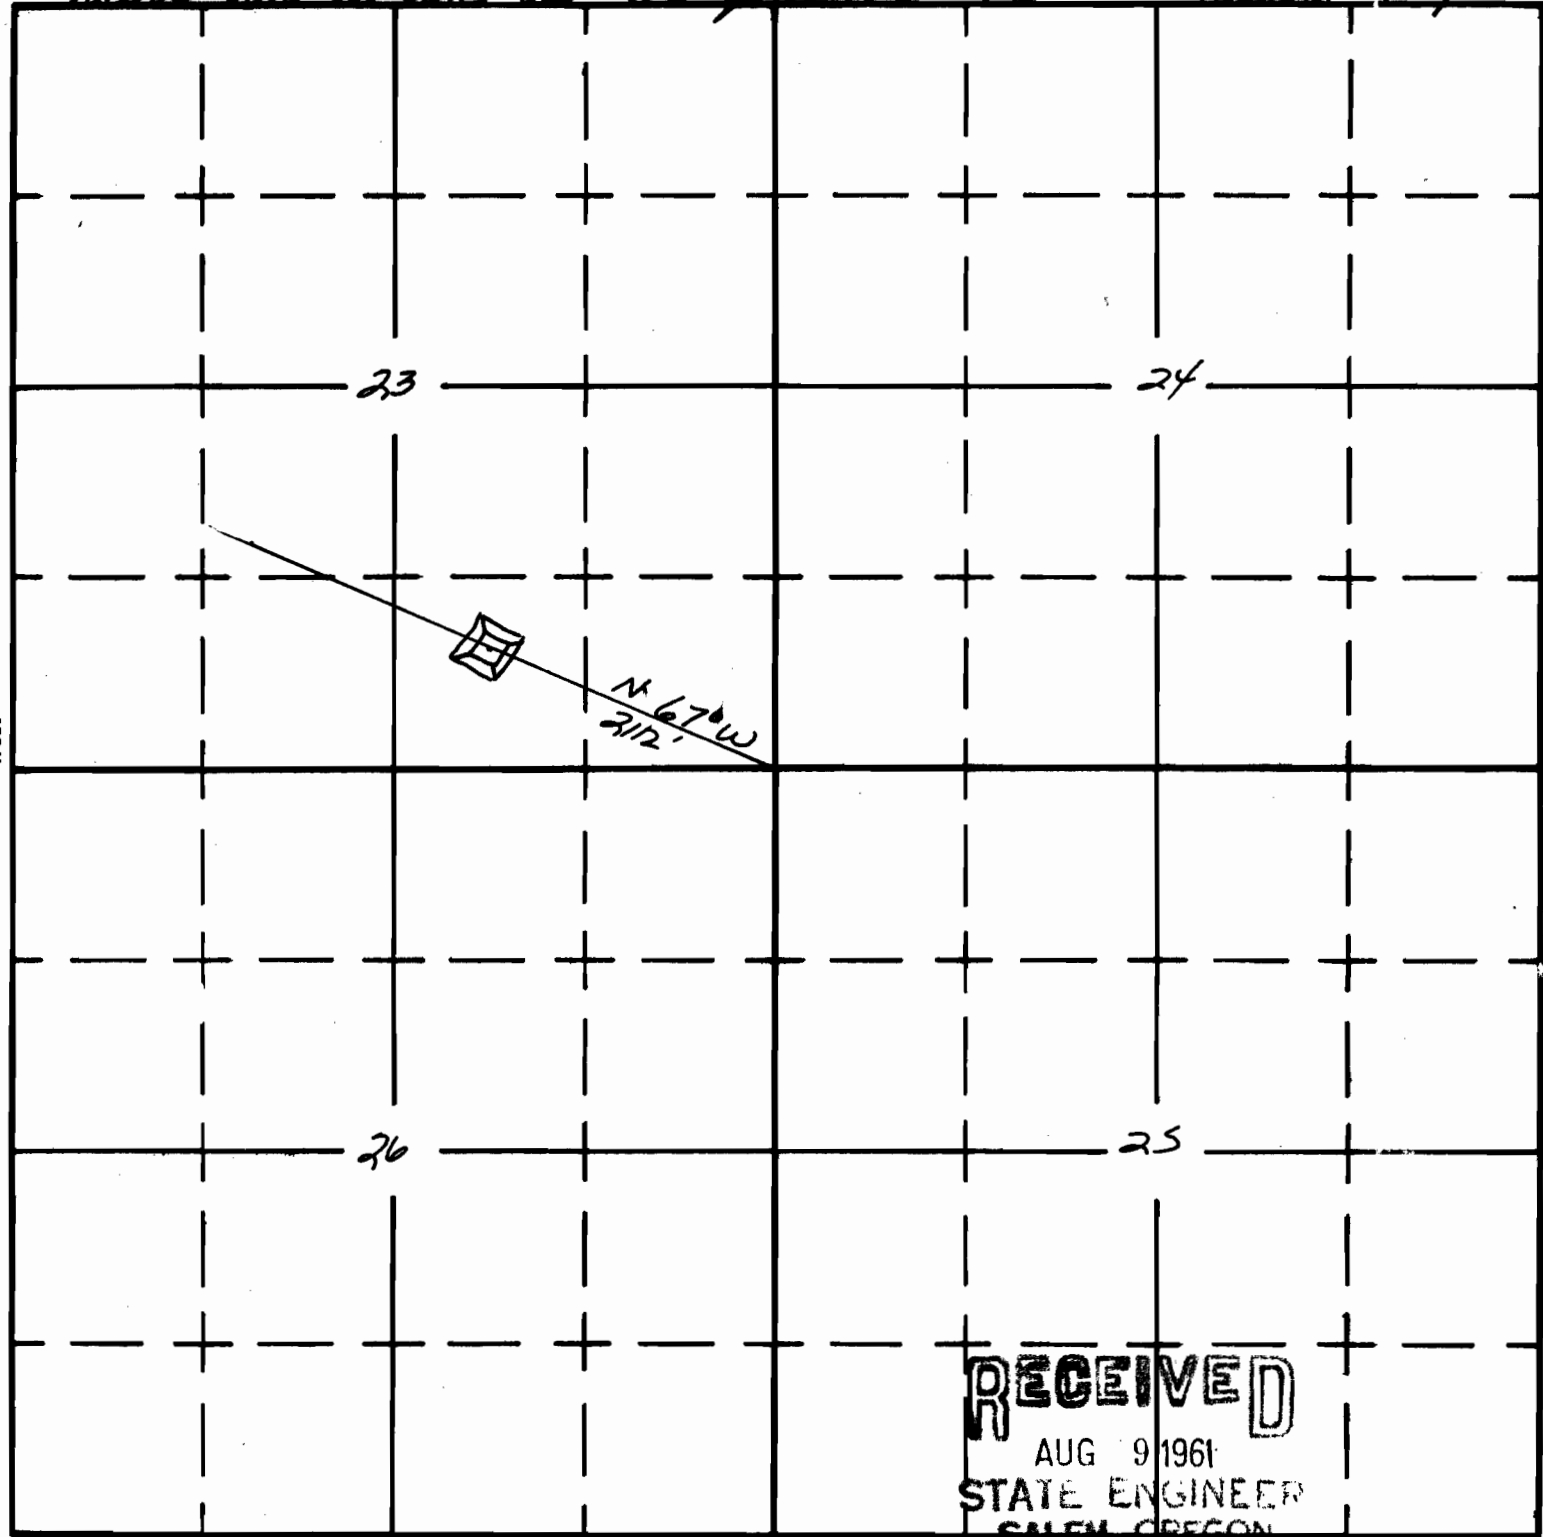

RECEIVED
AUG 9 1961
STATE ENGINEER
SALEM, OREGON