


✓ R-4142
62963

Howard Prairie Reservoir
Sec. 35 T.38S., R.3E.
Scale 4" = 1 mile

Stiffly cke i. mac.

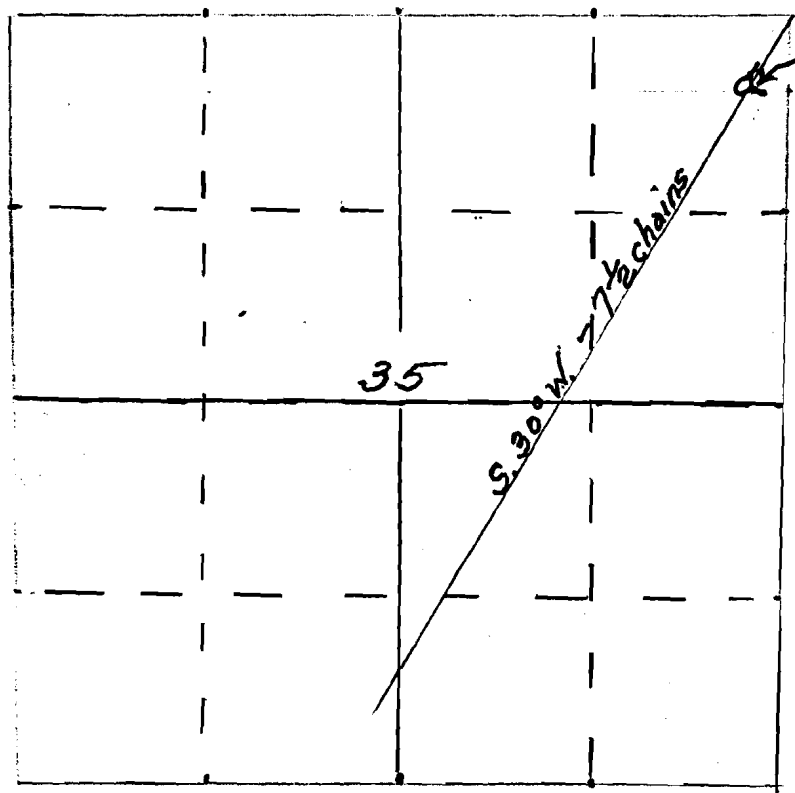

From the corner common to Secs. 25, 26, 35, 36
South 30° West - 7 1/2 chains to center of the
dam. Reservoir in the NE 1/4 NE 1/4 NE 1/4 Sec 35
T.38S., R.3E.

Application No. R-34179
Permit No. R-4142

RECEIVED
DEC 25 1960
STATE ENGINEER
