


✓ R-4143
62964

Randcore Pass Res.

Sec. 19 T. 40S., R. 4E.

Scale 4" = 1 mile

Young Ck. Meas.

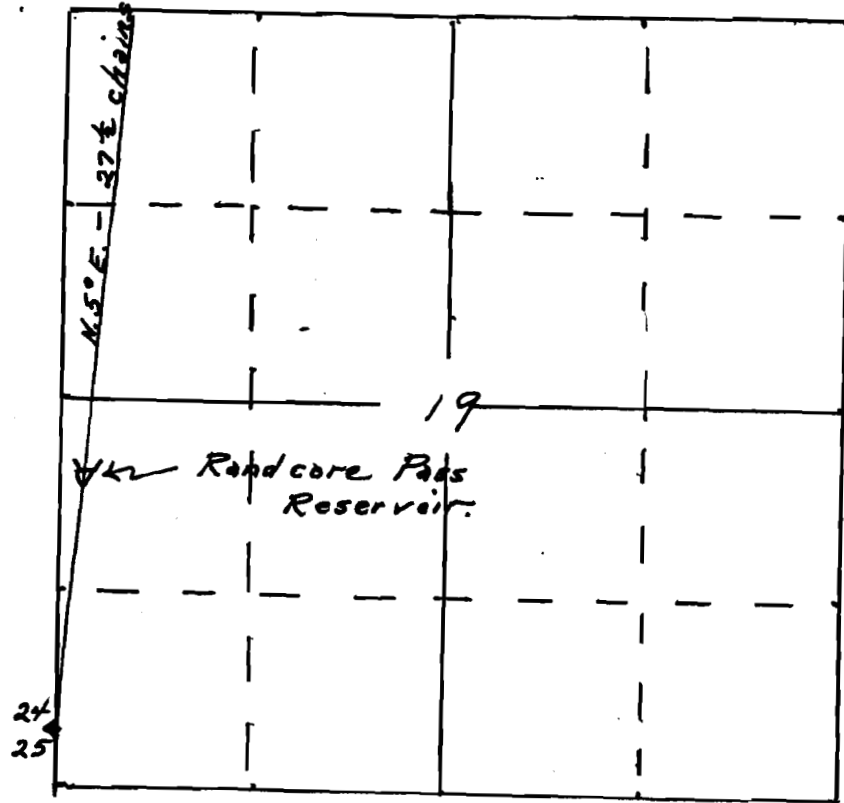

From the corner common to Sec 24, 25 T. 40S., R. 3E
N. 5° E. - 27 1/2 chains to the center of the dam.
Reservoir located in the NW 1/4 SW 1/4 Sec. 19 T. 40S., R. 4E.

Application No. R-34180
Permit No. R-4143

RECEIVED
DUG 25 1960
STATE ENGINEER