


✓ R-4147
62966

Hartwell Draw Reservoir

Sec. 32 T.40S, R4E.

Scale 4" = 1 mile.

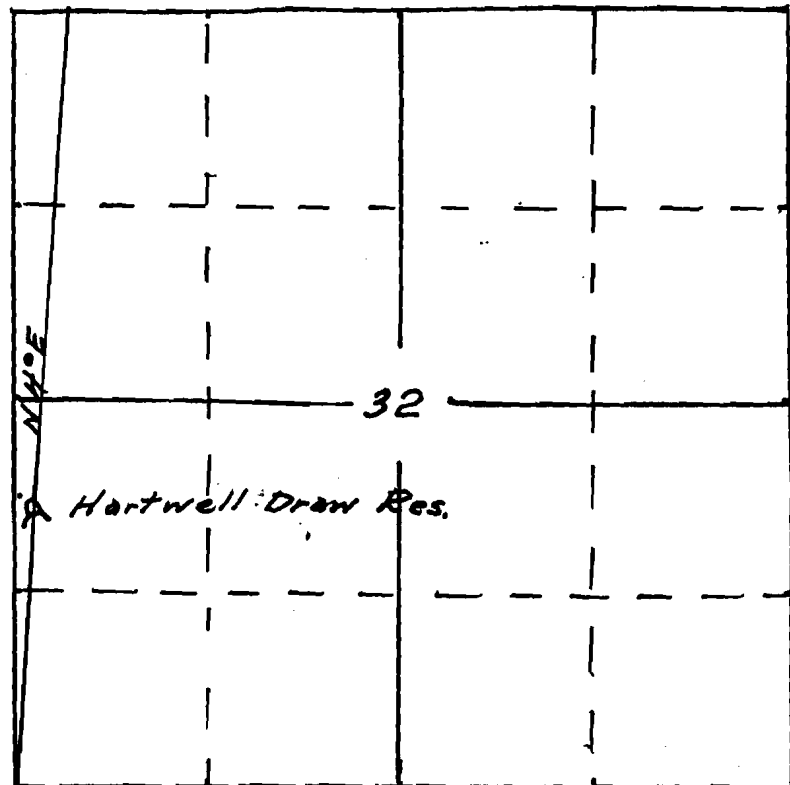

Hartwell Draw Res. Location From the SW corner

Sec. 32 T.40S, R4E. North 4° East 29 chains to center

of the dam. Reservoir in the NW 1/4 SW 1/4 Sec 32 T.40S, R4E.

RECEIVED
DEC 23 1980
STATE ENGINEER

Application No. R-34191
Permit No. R-4147