


✓ R-4150
62967

Bench Reservoir

Sec. 26 T.40S, R.3E.

Scale 4" = 1 mile

from cbr. misc.

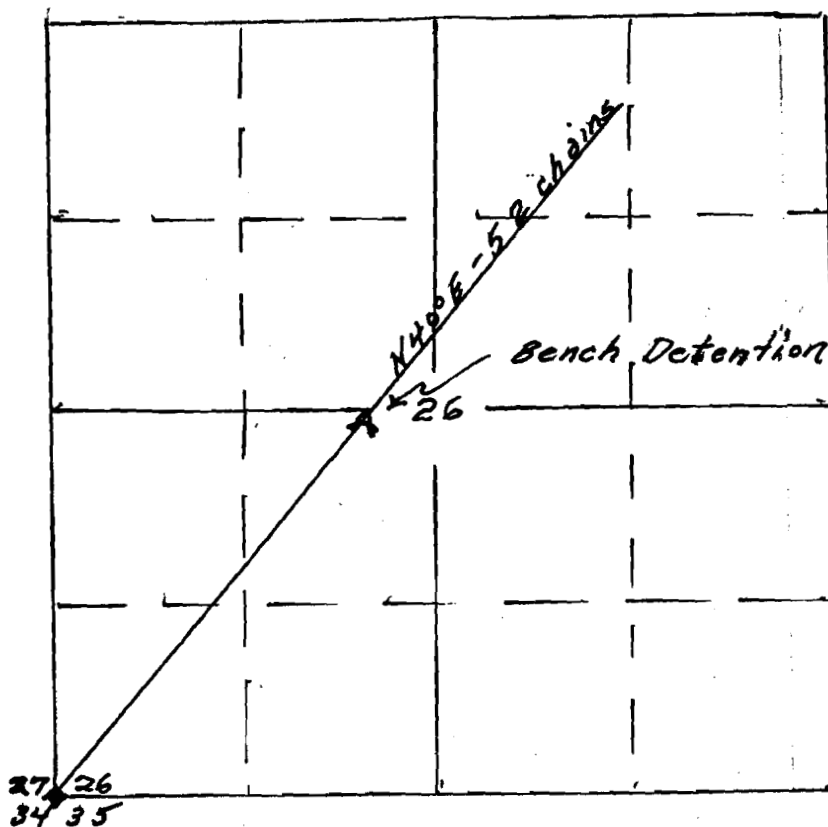

Location: From the corner common to Sec. 26, 27, 34, 35
T.40S, R.3E. - N40°E - 52 chains to the center of the
dam. Detention in the NE $\frac{1}{4}$ NE $\frac{1}{4}$ SW $\frac{1}{4}$ Sec. 26 T.40S R.3E

Application No. R-34194
Permit No. R-4150

DEC 28 1960
STATE ENGINEER