

TIPN

5

NE  $\frac{1}{4}$  SW  $\frac{1}{4}$



✓ R-4151  
62968

TOWNSHIP 41S RANGE 4E, W. M.

North.

Johnny C. Mize.

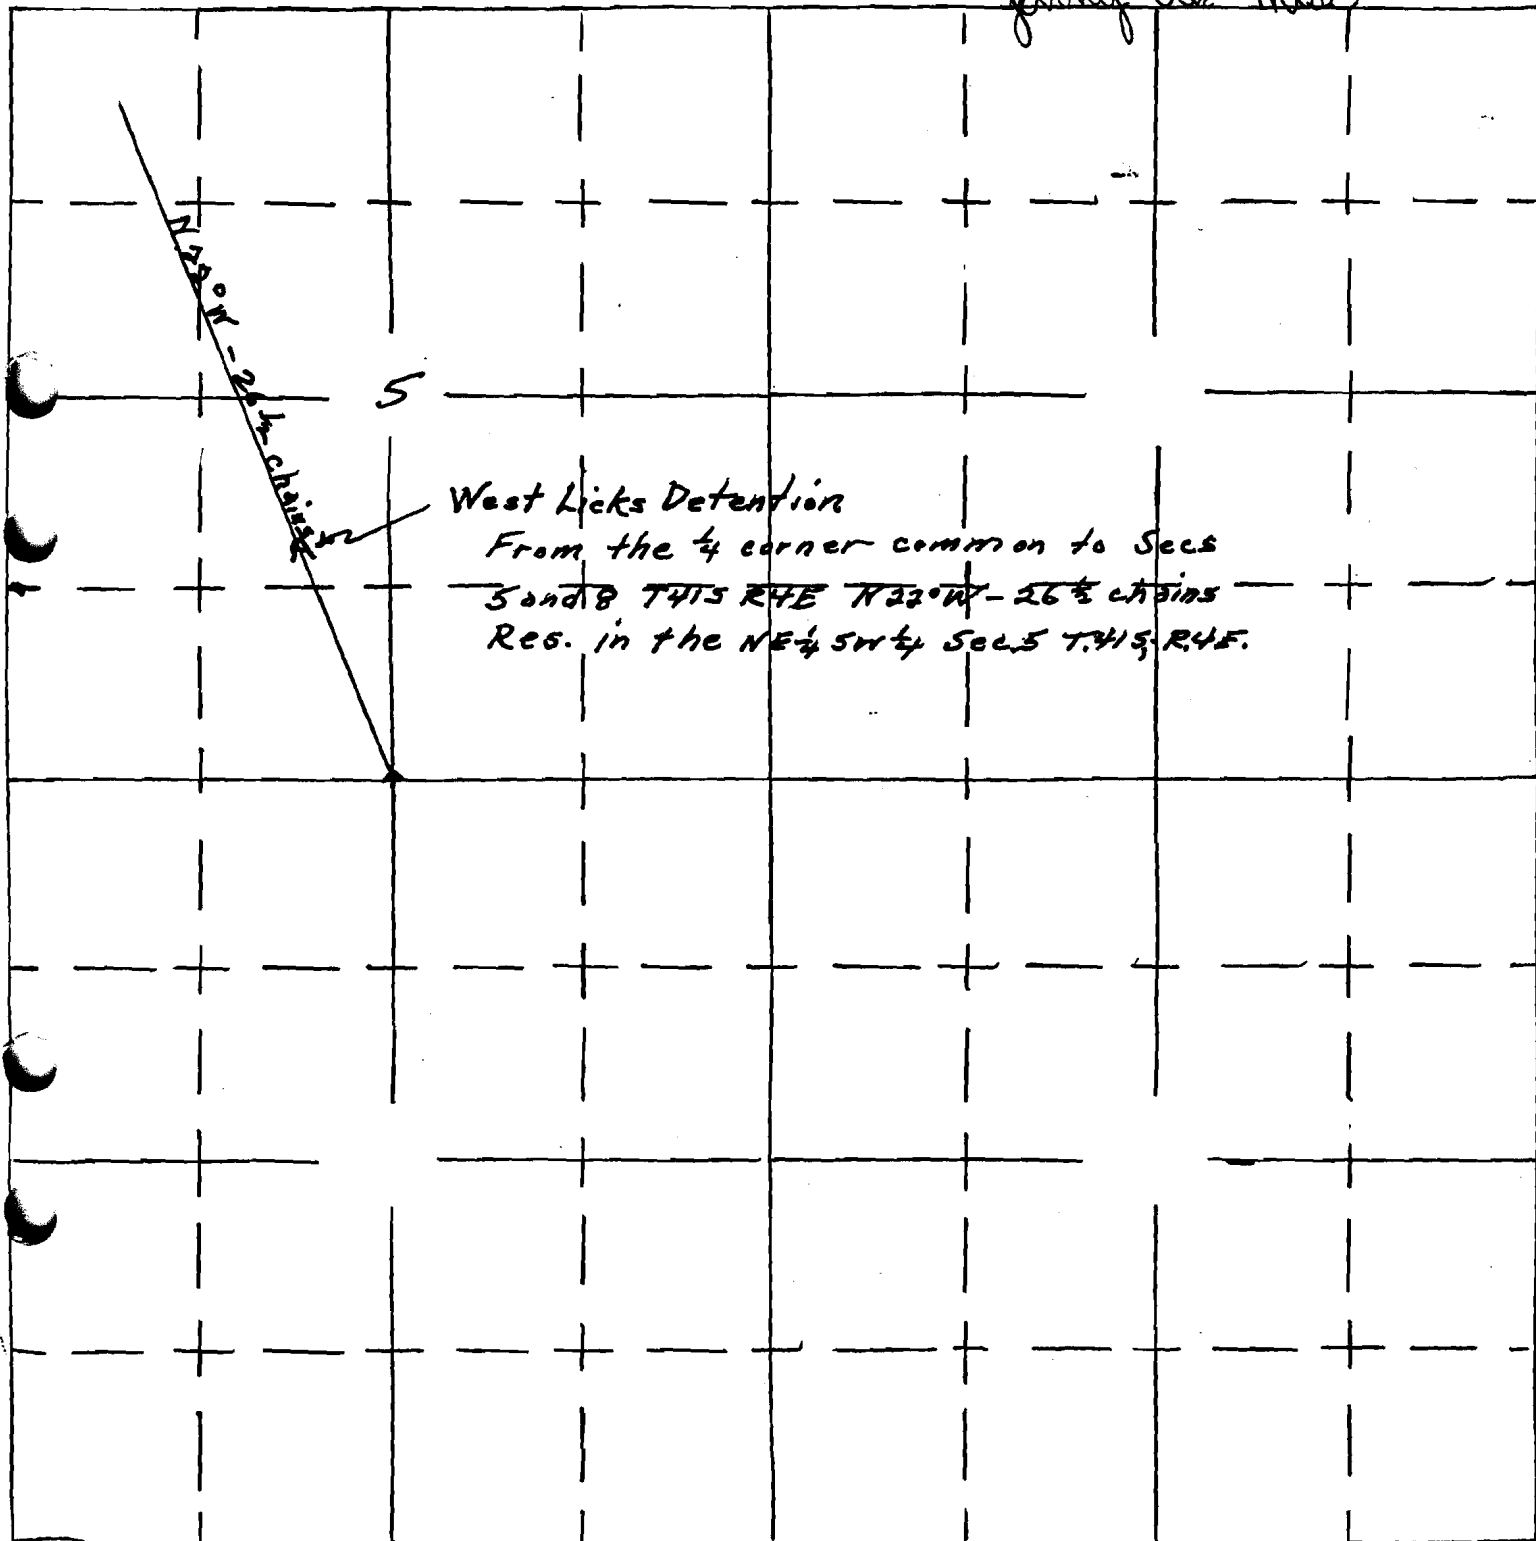

Application No. R-34247  
Permit No. R-4151

