

UNITED STATES
DEPARTMENT OF THE INTERIOR
BUREAU OF LAND MANAGEMENT


SECTION

SW NE Sec. 33

Oregon State Water Filings

TOWNSHIP 39S, RANGE 26E, W. M.

North *No corner found
Tied in with aerial photos and OSHD Quad Maps*

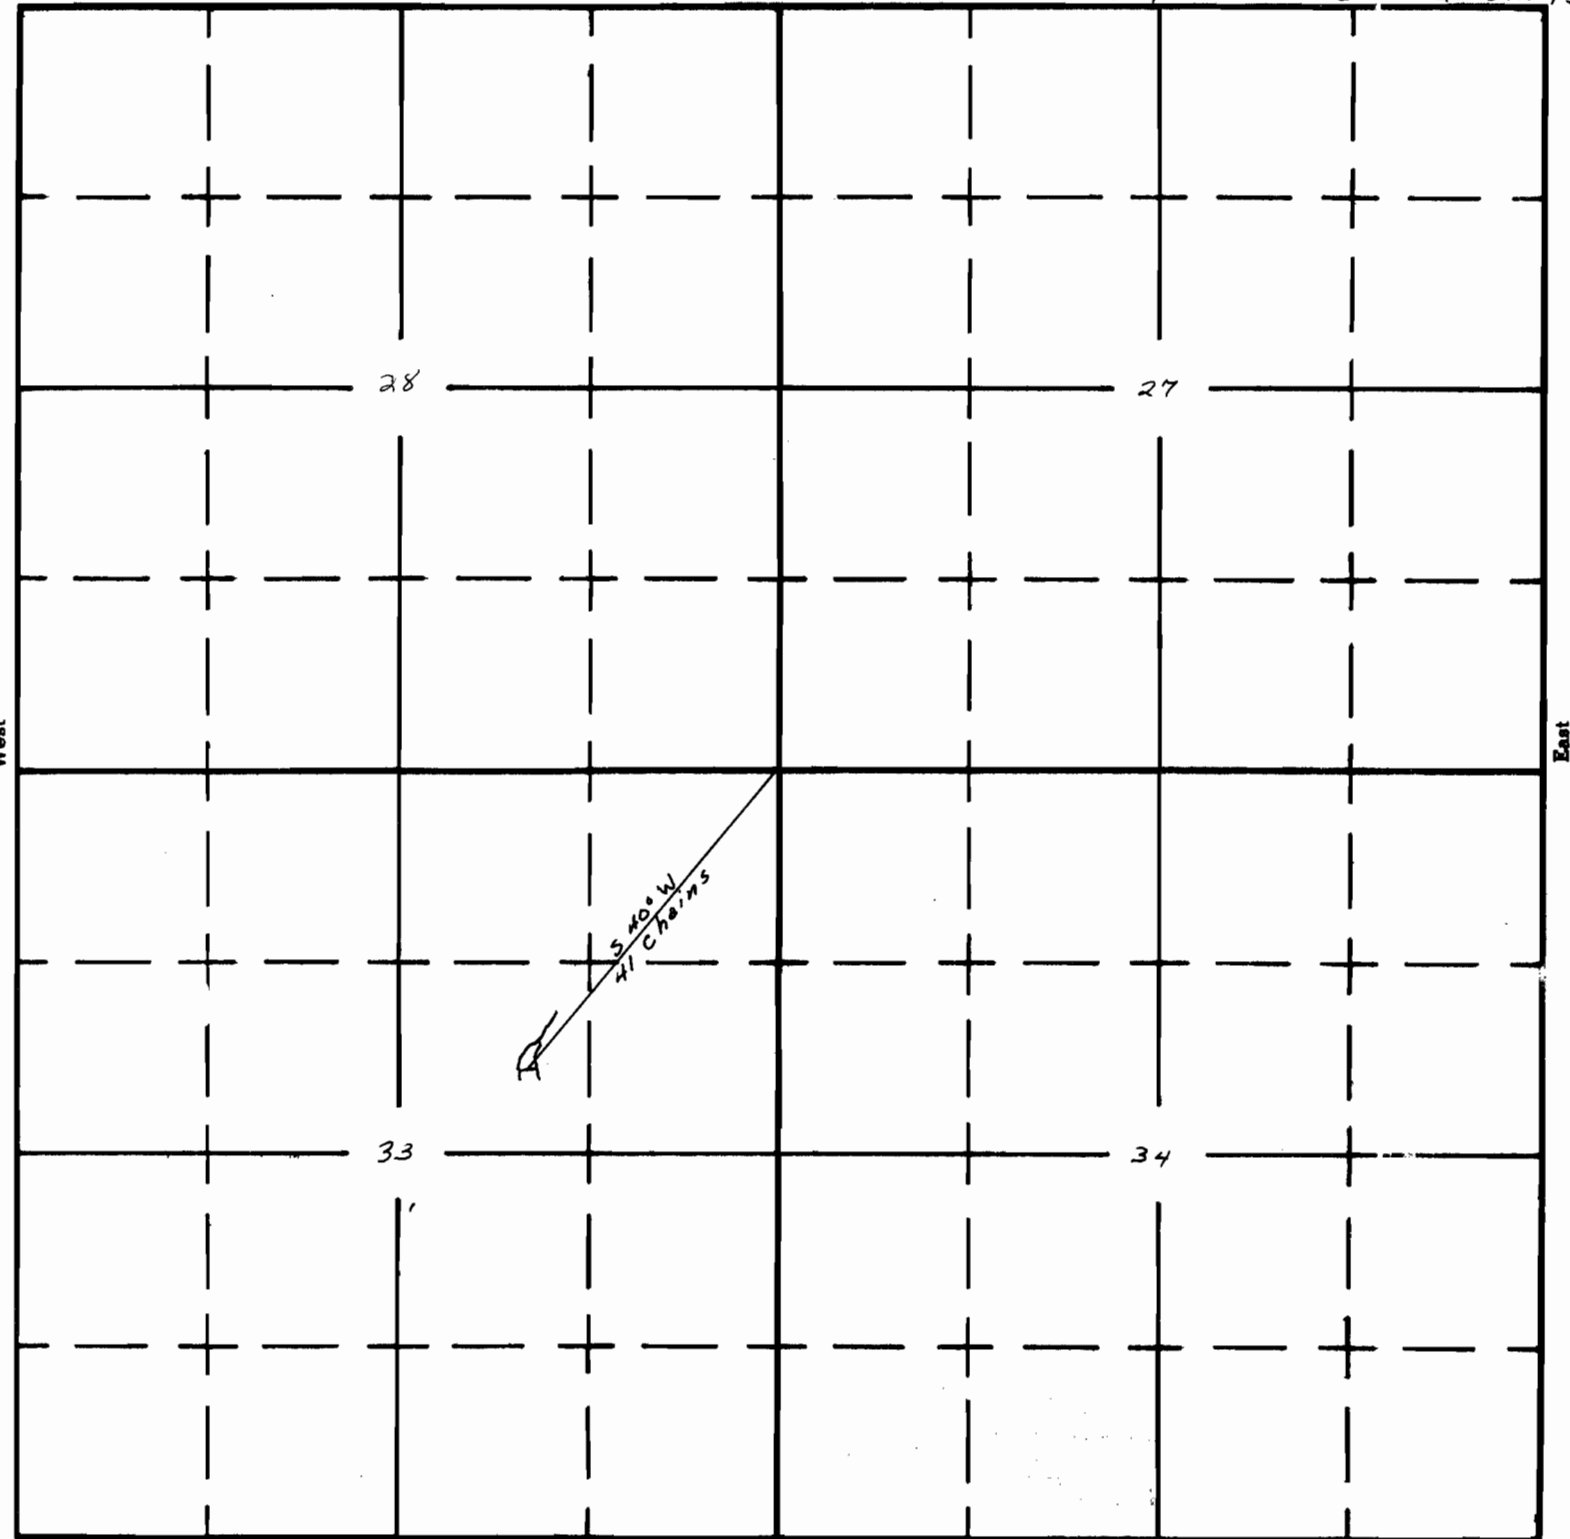

South

APPLICATION No. R-35171
PERMIT No. R-4158