

UNITED STATES
DEPARTMENT OF THE INTERIOR
BUREAU OF LAND MANAGEMENT

SECTION


NE $\frac{1}{4}$ NE $\frac{1}{4}$

SEC. 32

Oregon State Water Filings

TOWNSHIP 32 S, RANGE 32 $\frac{3}{4}$ E, W. M.

North

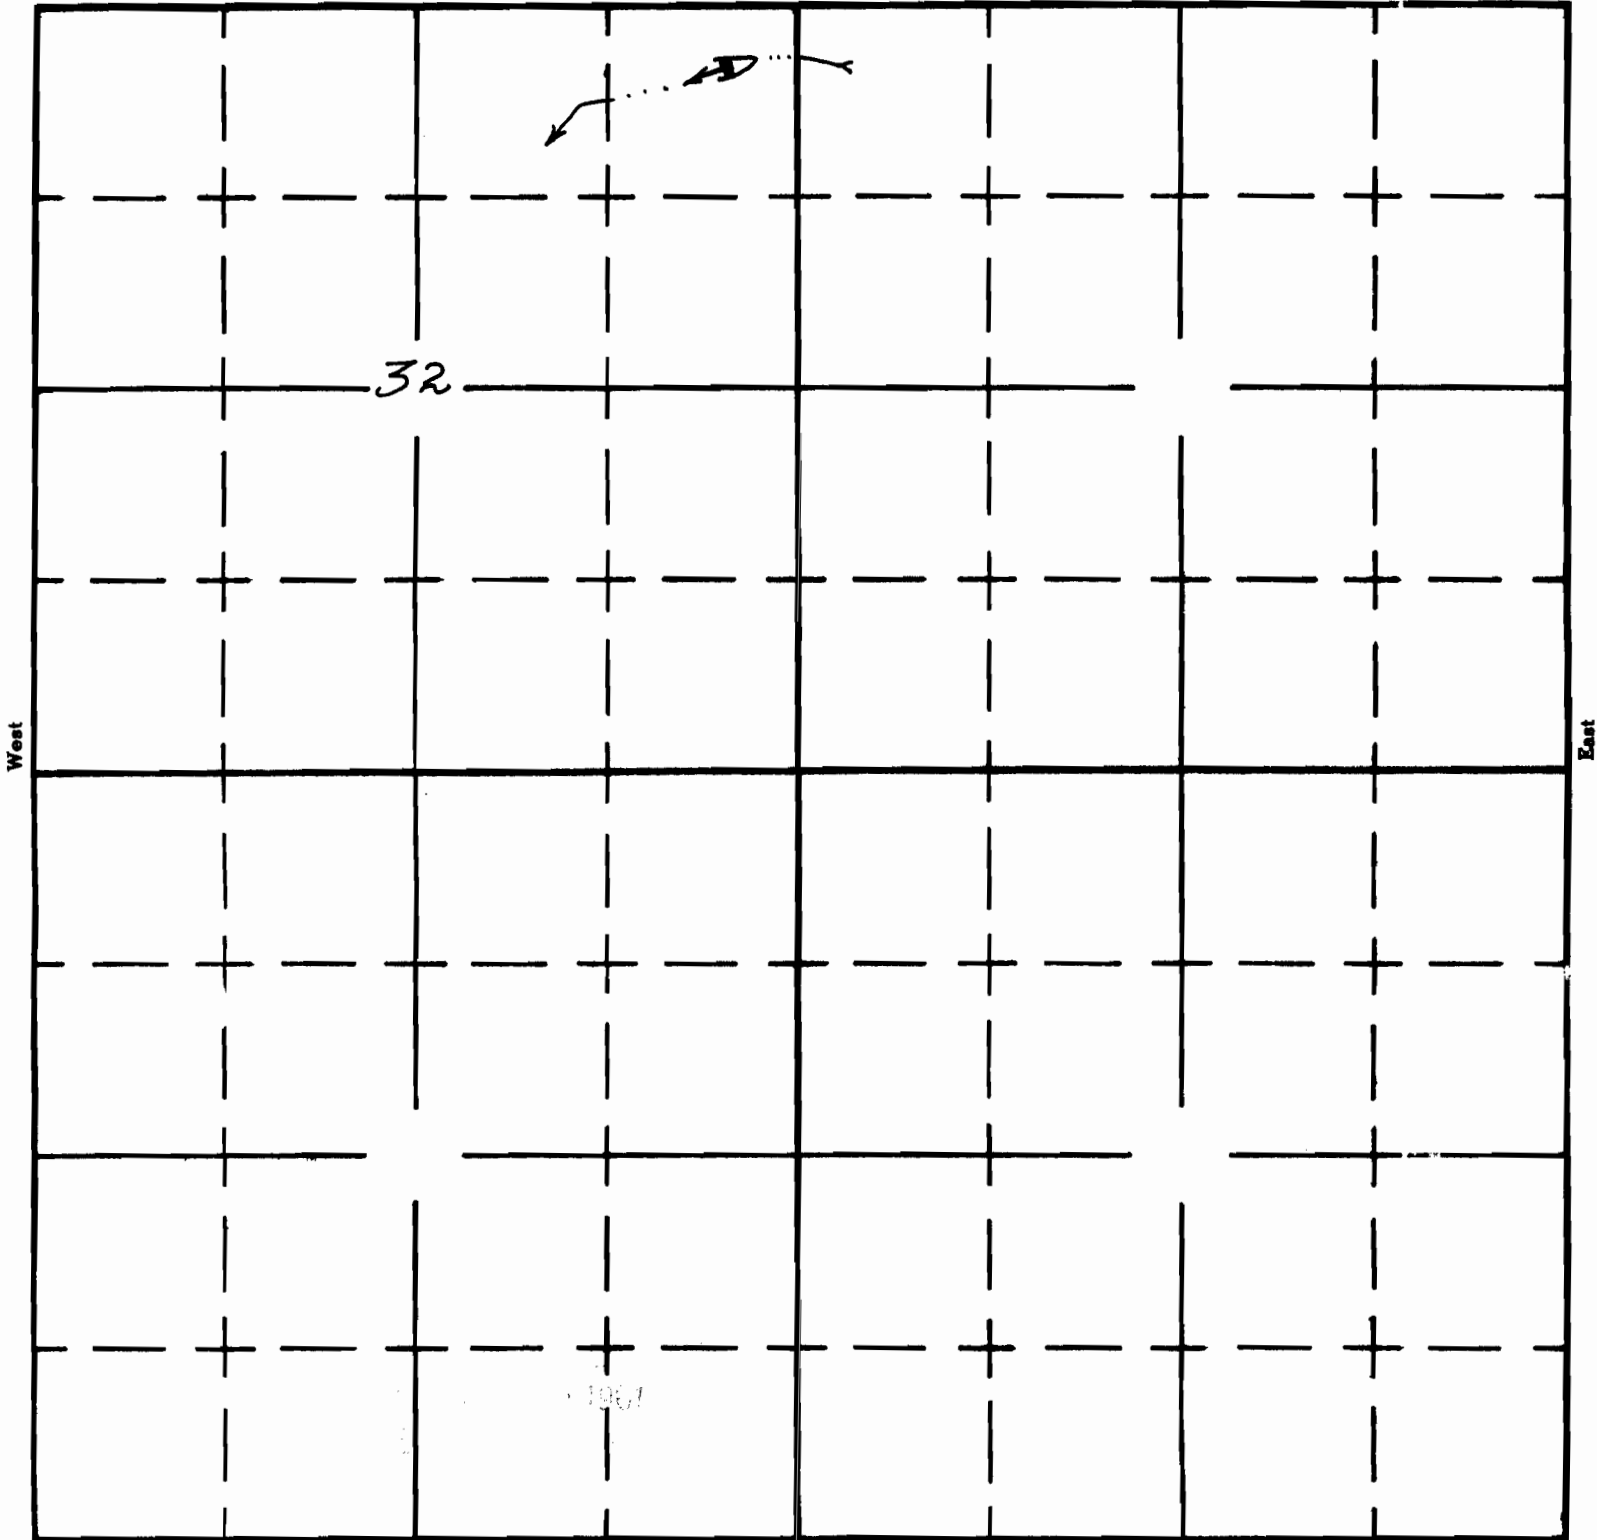

UNNAMED
FISH CR

South

APPLICATION No. R-35486
PERMIT No. R-4170