

Form AI-187
March 1961

UNITED STATES
DEPARTMENT OF THE INTERIOR
BUREAU OF LAND MANAGEMENT

SECTION


SE 1/4 NW 1/4

Oregon State Water Filings

9

TOWNSHIP 40 S, RANGE 37 E, W. M.

North

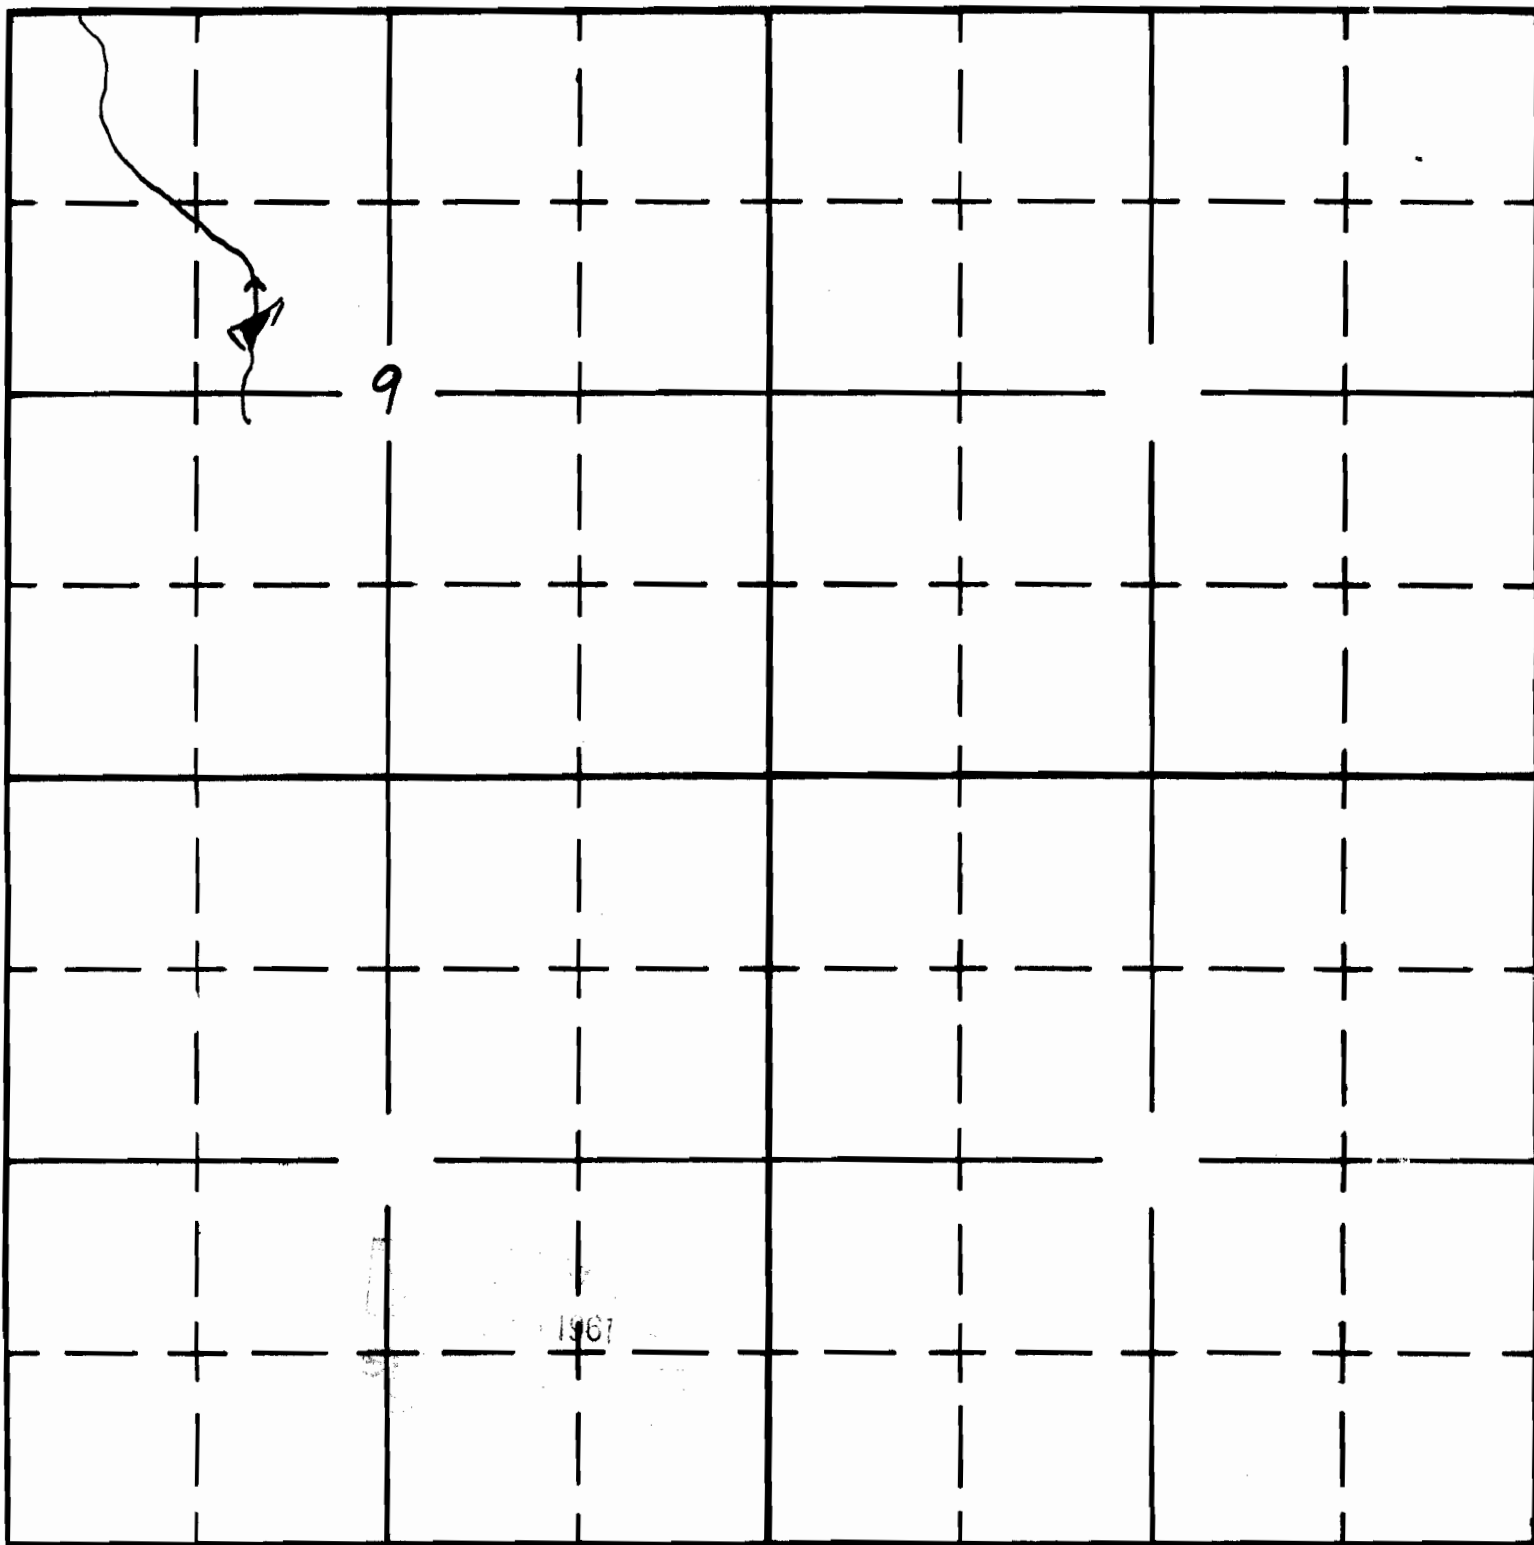

South

APPLICATION No. **R-35503**

PERMIT No. **R-4182**