

Form AI-187
March 1961

UNITED STATES
DEPARTMENT OF THE INTERIOR
BUREAU OF LAND MANAGEMENT

SECTION


Oregon State Water Filings

NE 1/4 SW 1/4

TOWNSHIP 29S, RANGE 29E, W. M.

Sec. 13

North

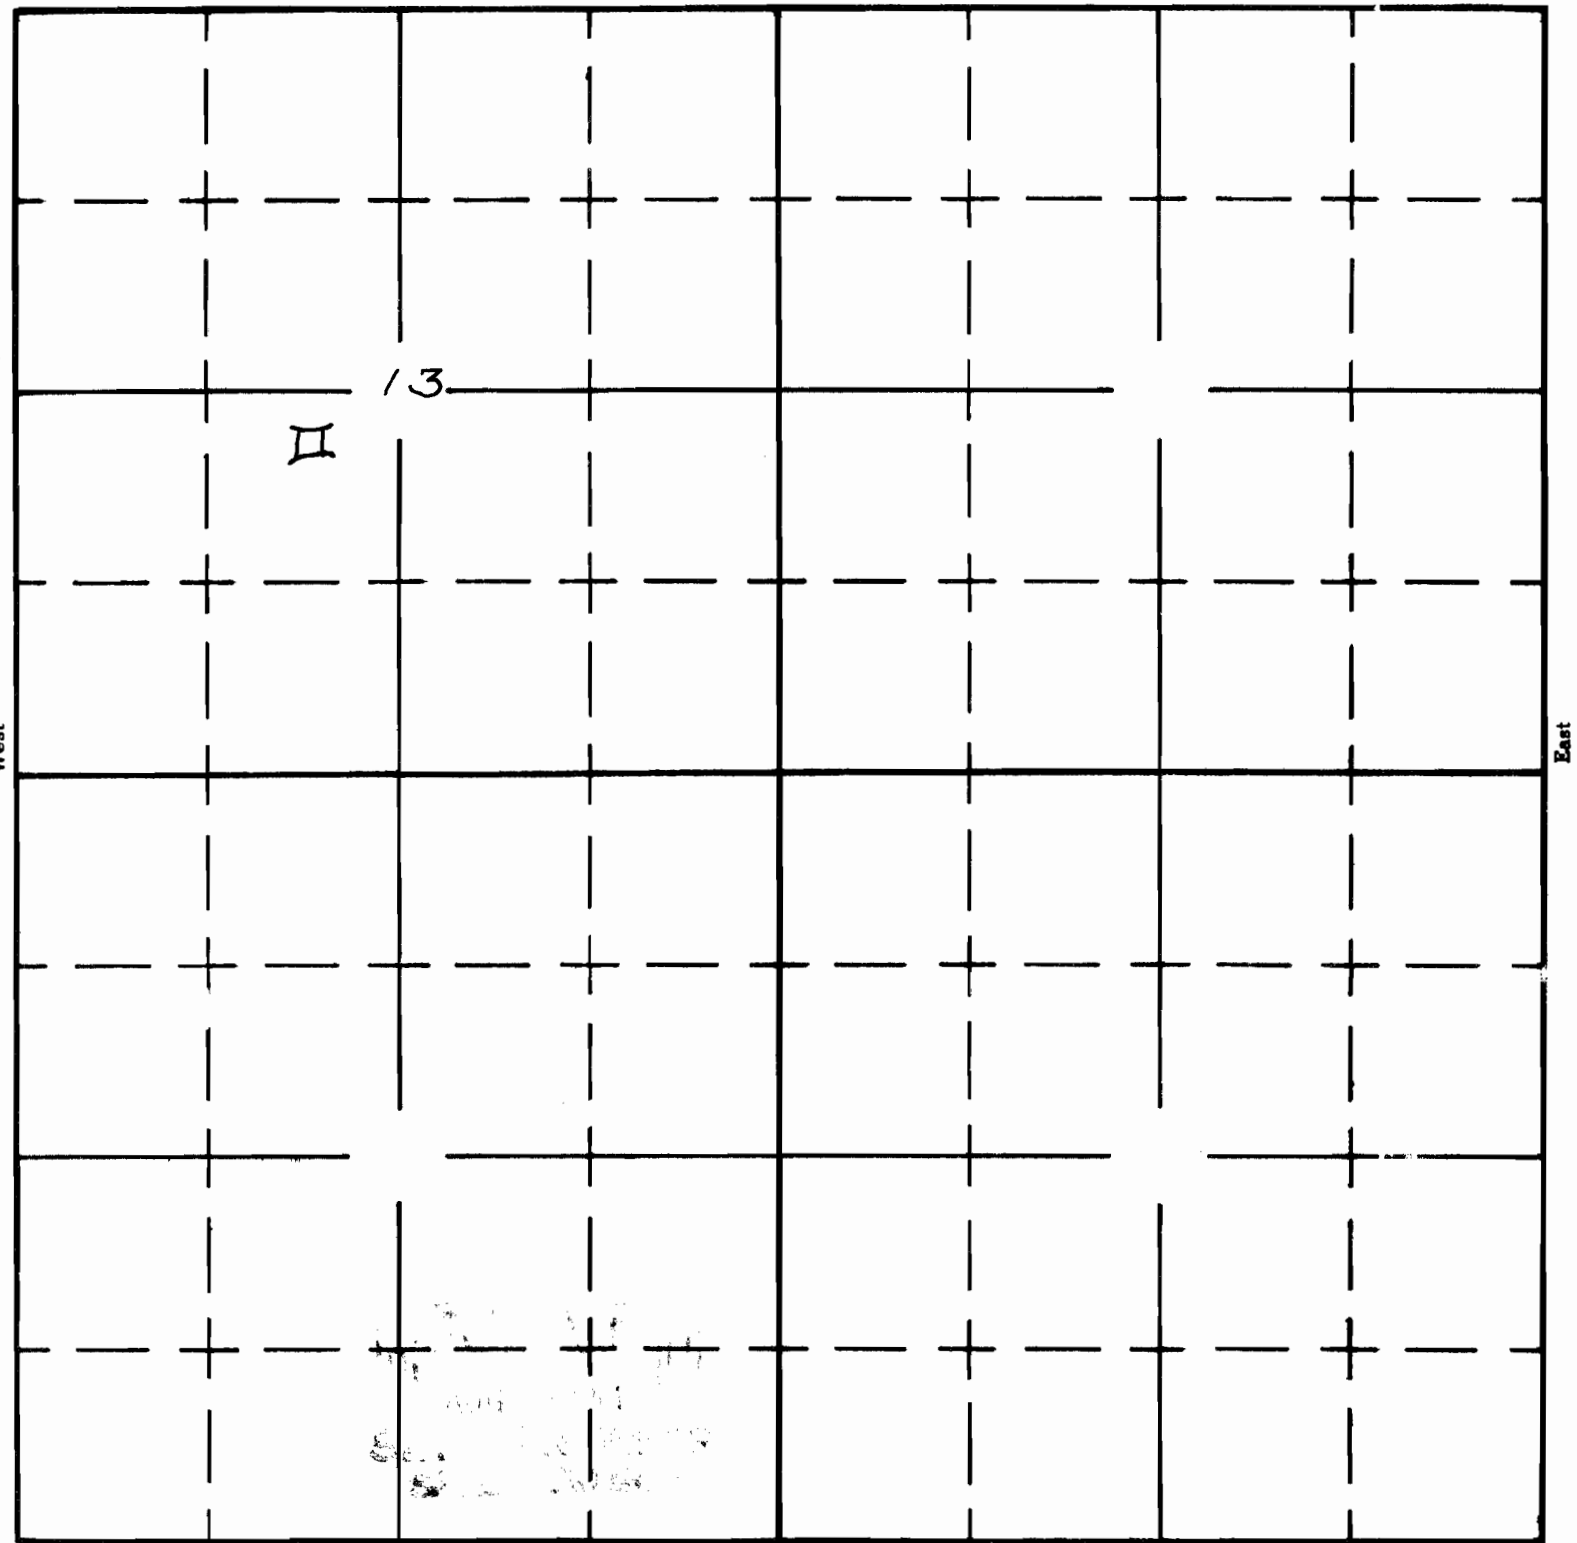

South

APPLICATION No R-35919
PERMIT No. R-4215