

Form AI-187
March 1961

UNITED STATES
DEPARTMENT OF THE INTERIOR
BUREAU OF LAND MANAGEMENT


SECTION
31

Oregon State Water Filings

NE 1/4 SW 1/4

TOWNSHIP 29S, RANGE 29E, W. M.

Tied in with aerial photo of 2.54.0 Quad Maps.

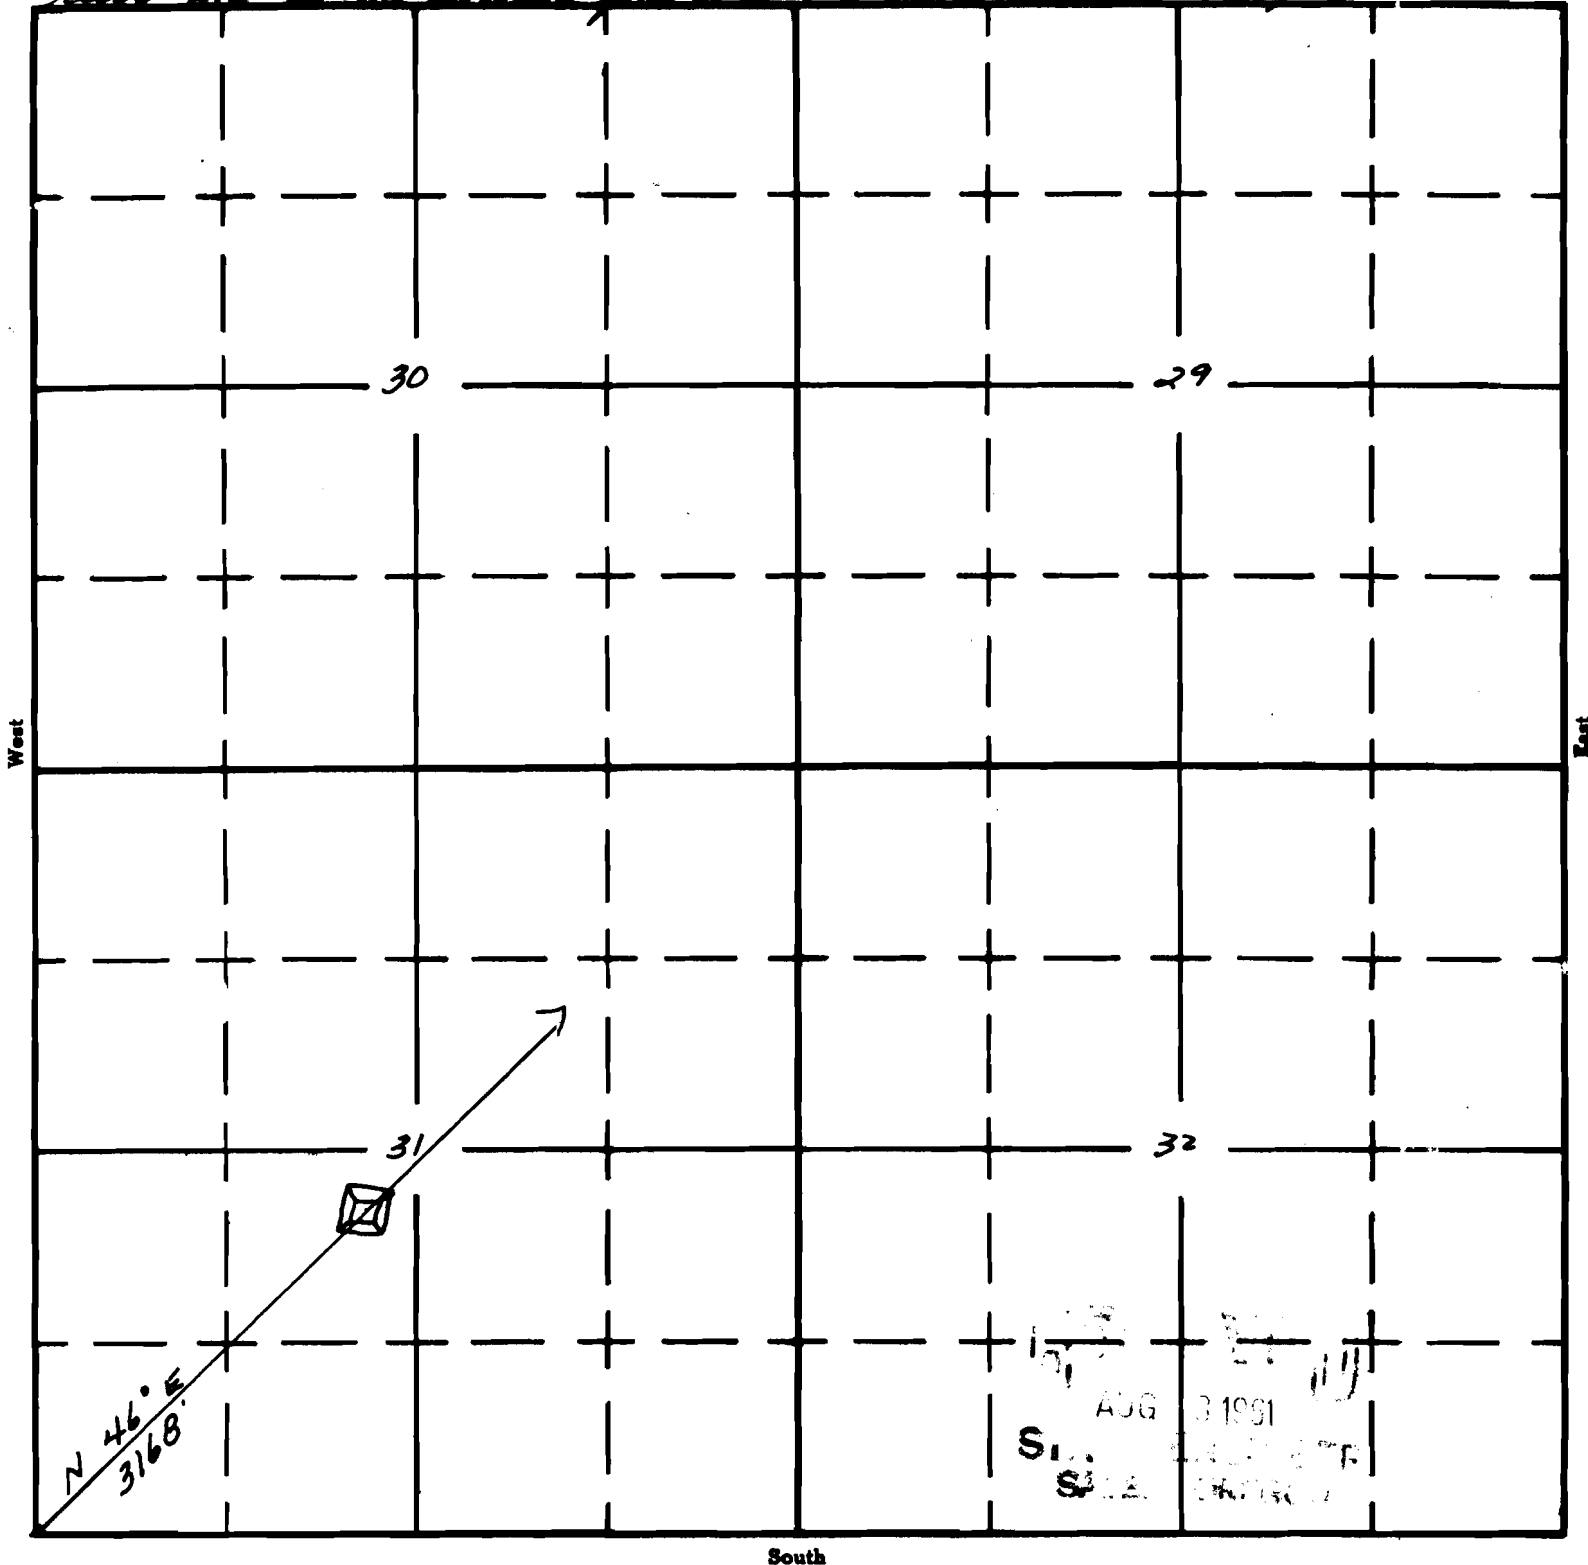

101
AUG 3 1961

APPLICATION No. R-36376

PERMIT No. R-4224