

Form AI-187
March 1961

UNITED STATES
DEPARTMENT OF THE INTERIOR
BUREAU OF LAND MANAGEMENT

SECTION


14

Oregon State Water Filings

SW 1/4 SE 1/4

TOWNSHIP 29S, RANGE 28E, W. M.

Filed in unit aerial photo: O.S.U.D. Quad Map.

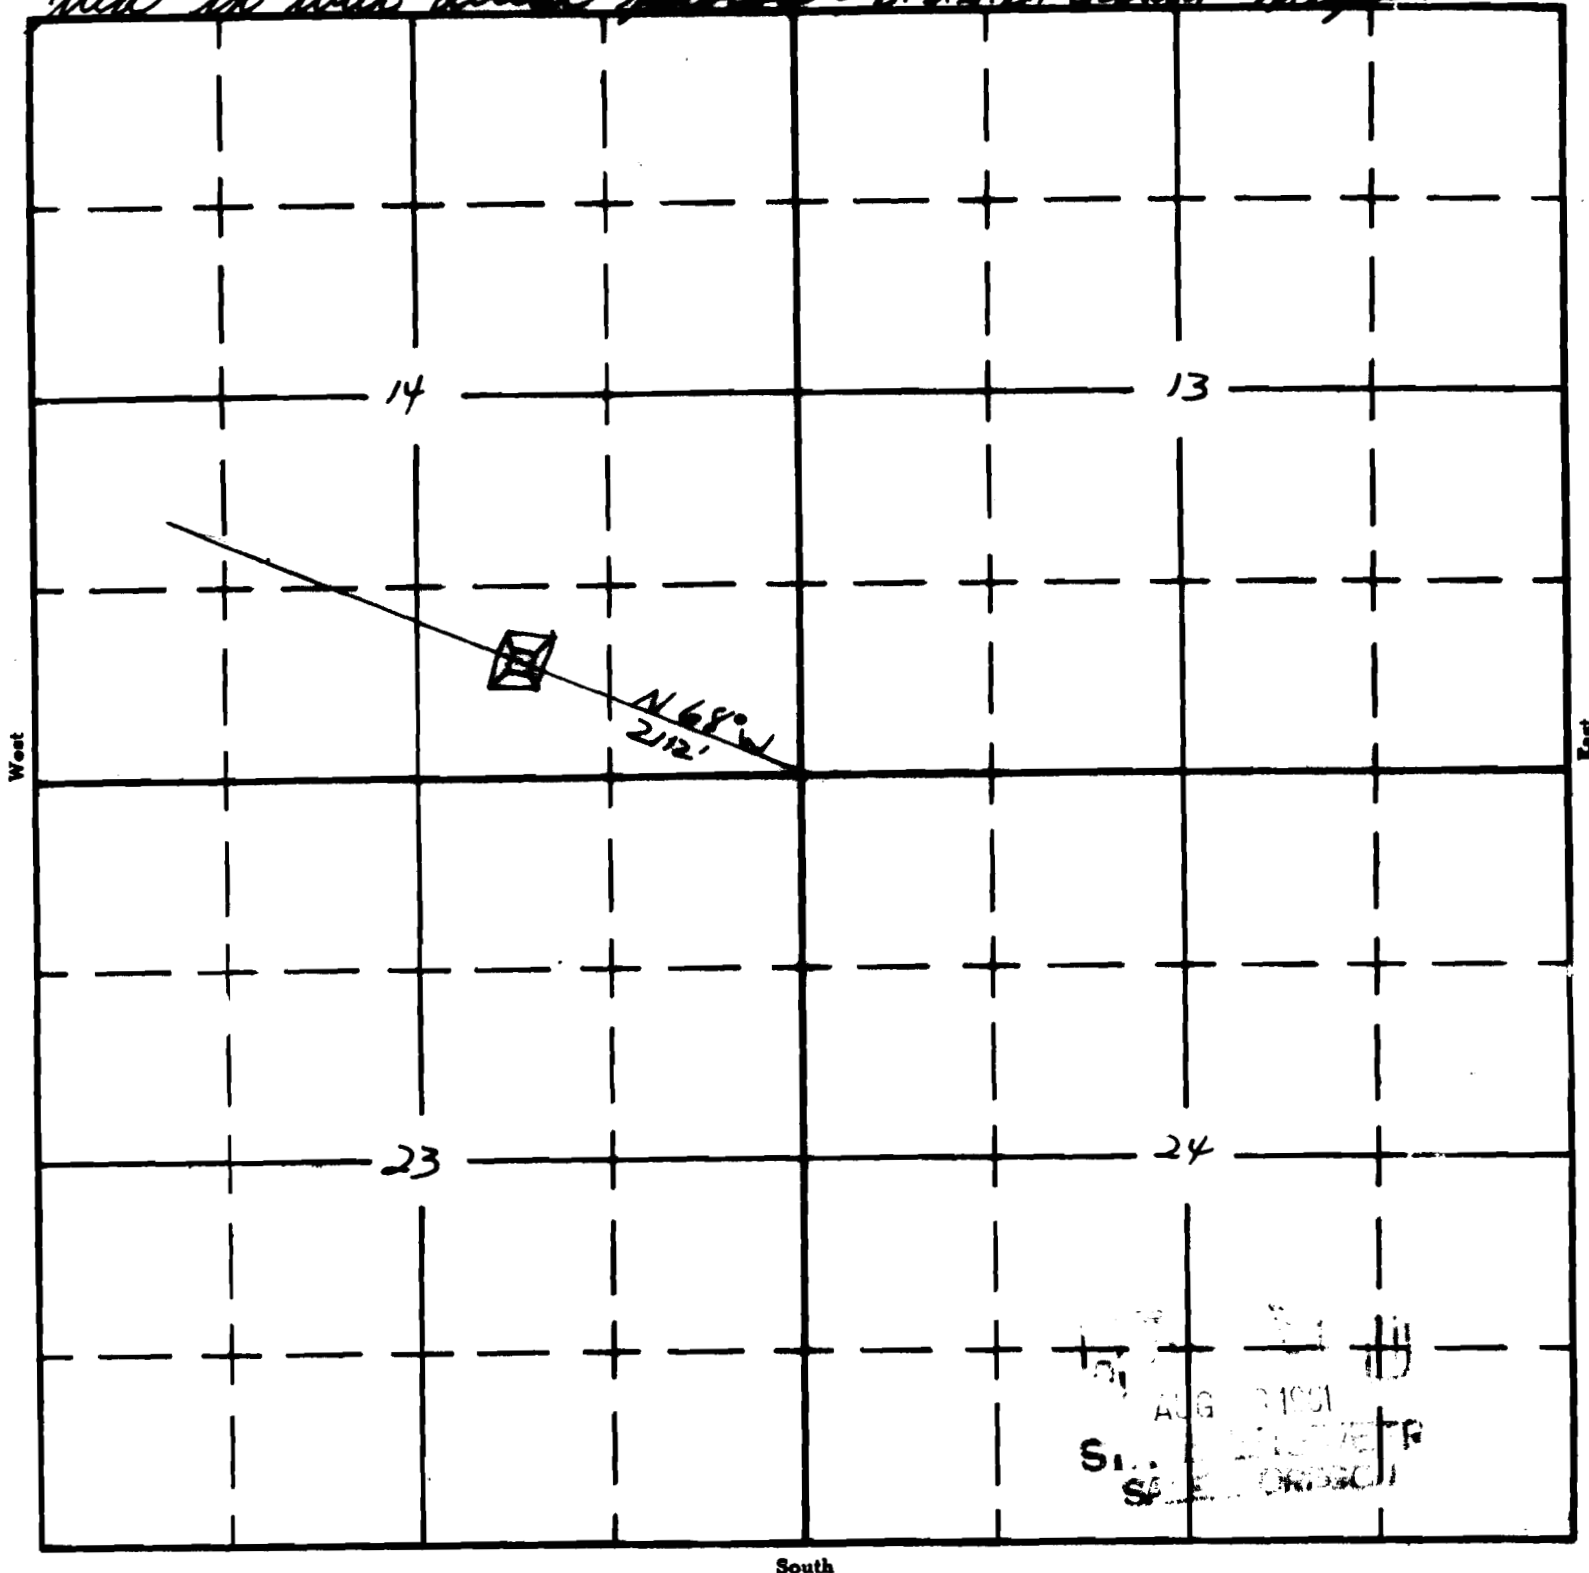

APPLICATION No. R-26377