

Form AL-287
March 1961

UNITED STATES
DEPARTMENT OF THE INTERIOR
BUREAU OF LAND MANAGEMENT

SECTION 20

Oregon State Water Filings

RECEIVED


TOWNSHIP 30S, RANGE 29E, W. M.

SEP 21 1987

~~NE 1/4 NE 1/4~~
NE 1/4 NE 1/4

WATER RESOURCES DEPT.
OREGON

Tied in with aerial photos North of O.S.H.D. Quad

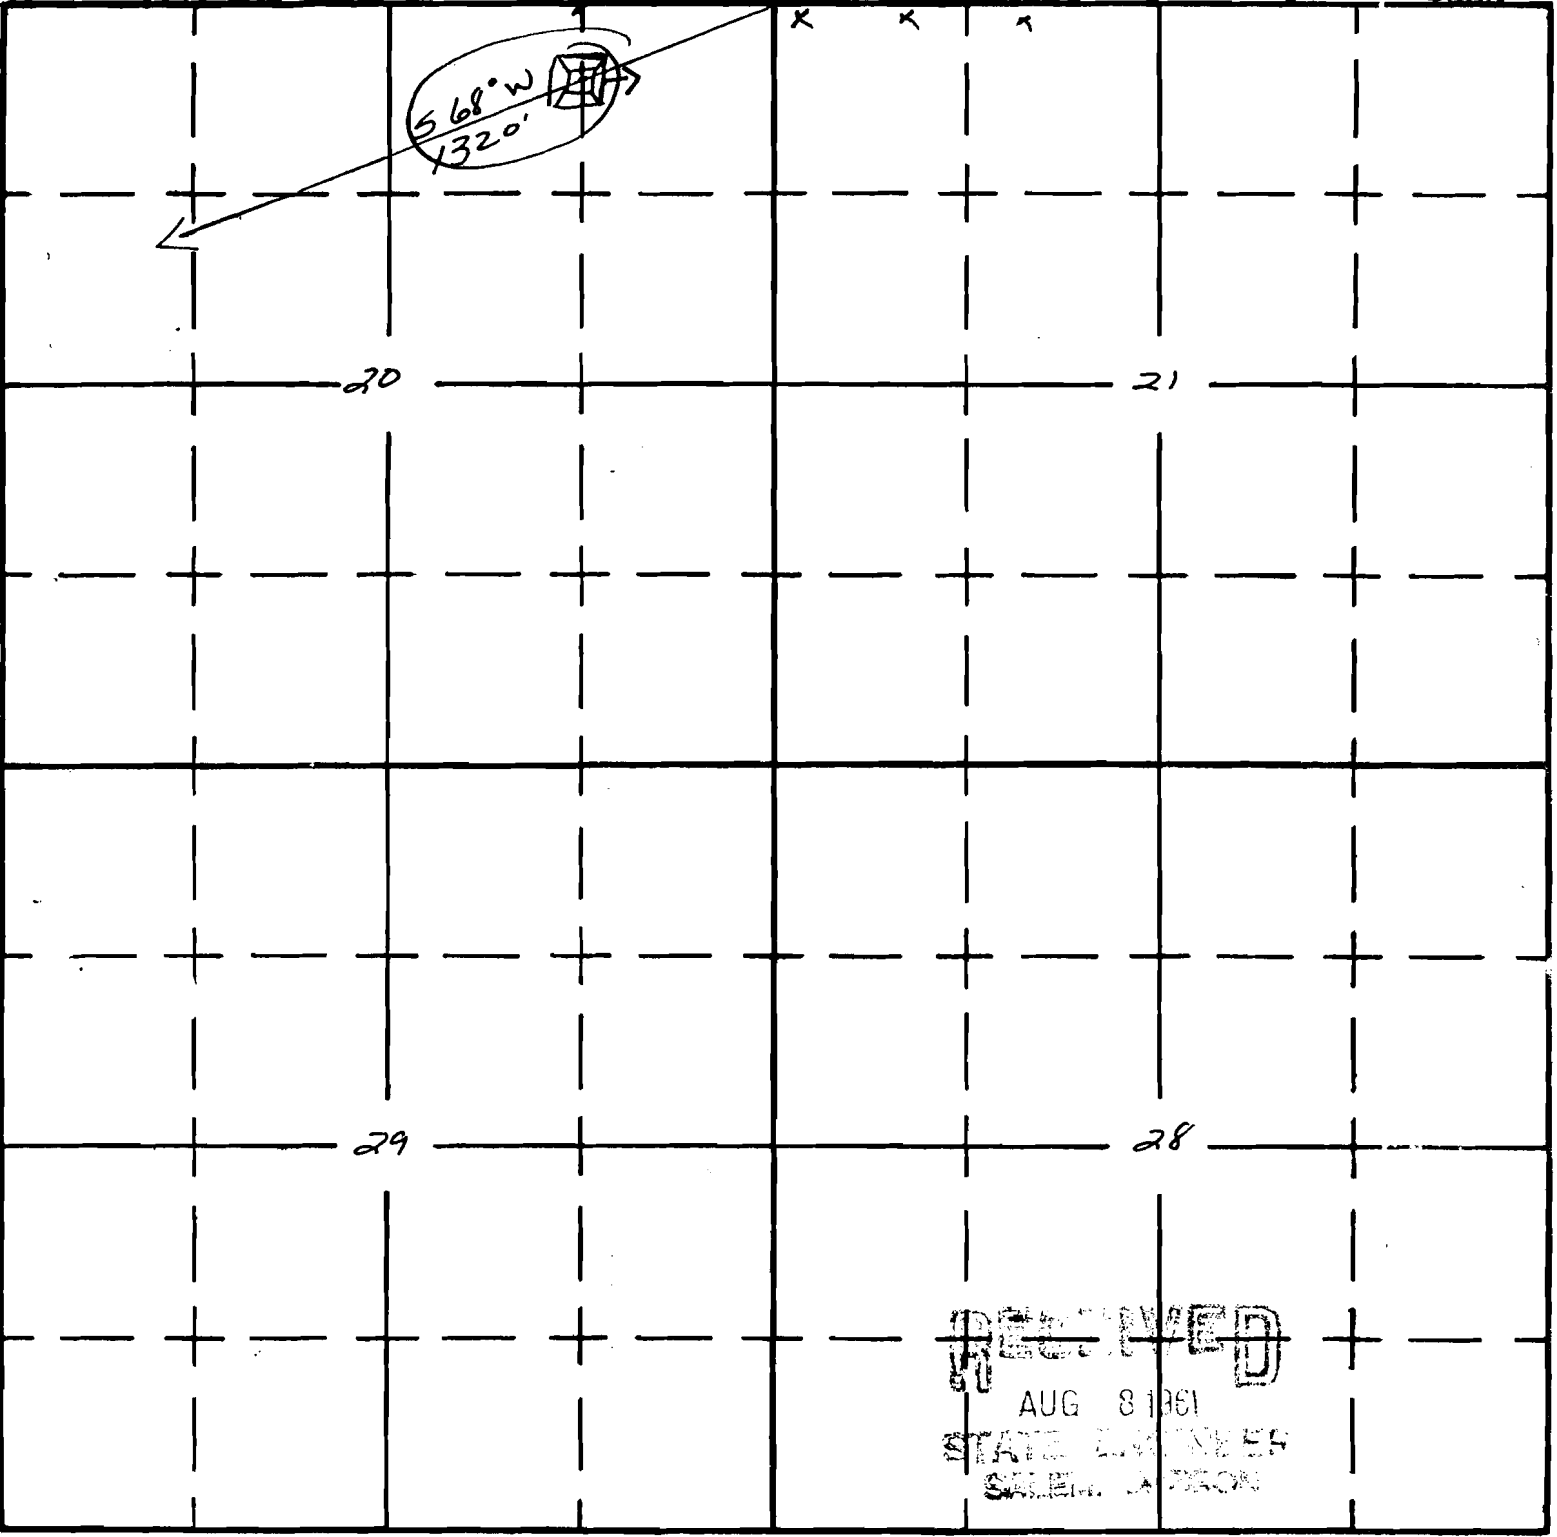

RECEIVED

AUG 8 1961
STATE ENGINEER
SALEM, OREGON

South

APPLICATION No. R-36379
PERMIT No. R-4227