

Form AI-187
March 1961

UNITED STATES
DEPARTMENT OF THE INTERIOR
BUREAU OF LAND MANAGEMENT


SECTION 33

Oregon State Water Filings

SE 1/4 SE 1/4

TOWNSHIP 40S, RANGE 29E, W. M.

Filed in with aerial photos & D.S. H. & D. Quad Maps

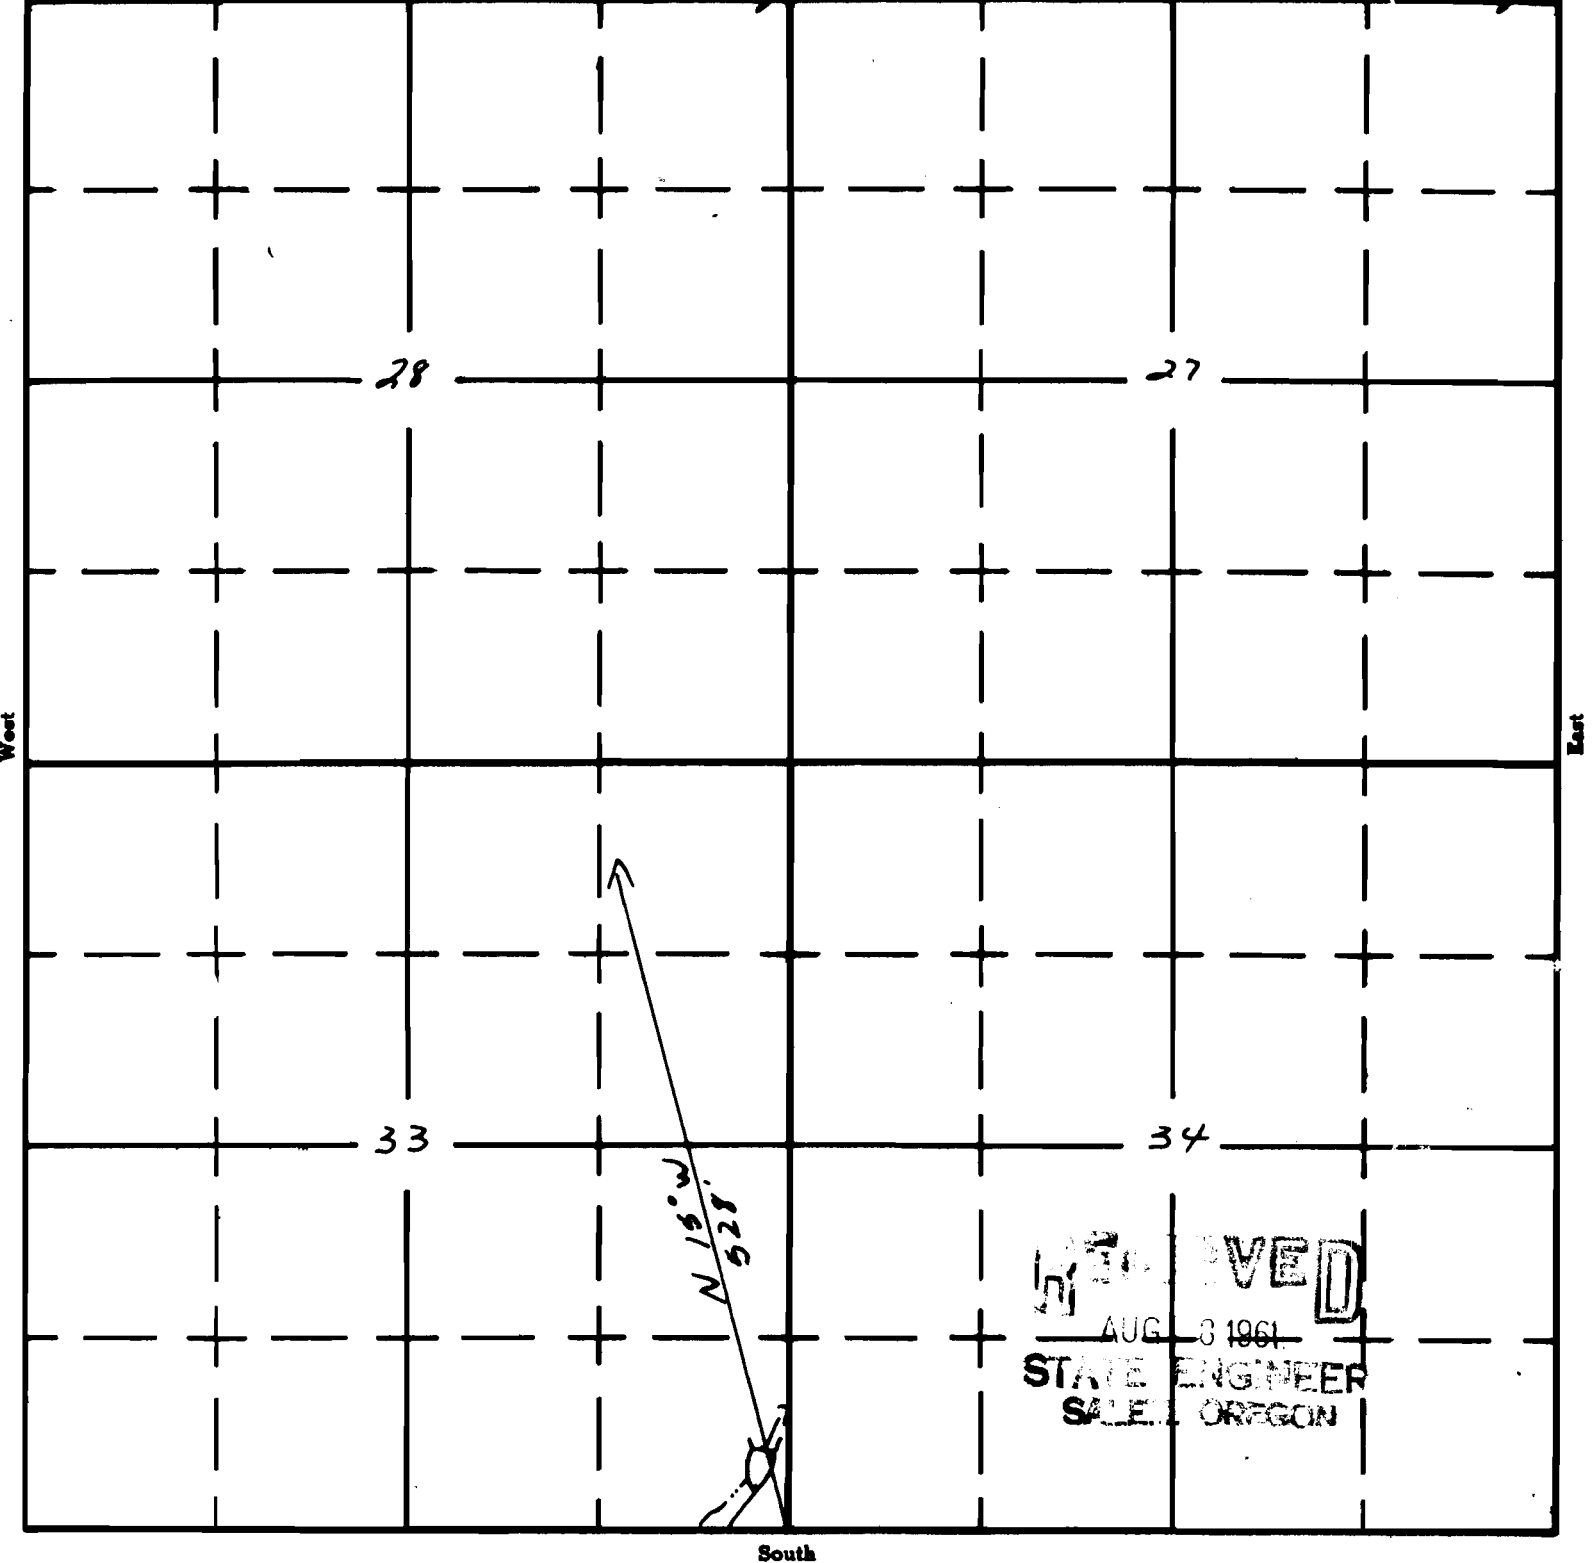

APPLICATION No. R-56386
PERMIT No. R-4231