

Form A1-187
March 1961

UNITED STATES
DEPARTMENT OF THE INTERIOR
BUREAU OF LAND MANAGEMENT

SECTION


3

NE¹ NE¹

Oregon State Water Filings

TOWNSHIP 38S, RANGE 28E, W. M.

North Tied in with aerial Photo and CSMO Grid Maps

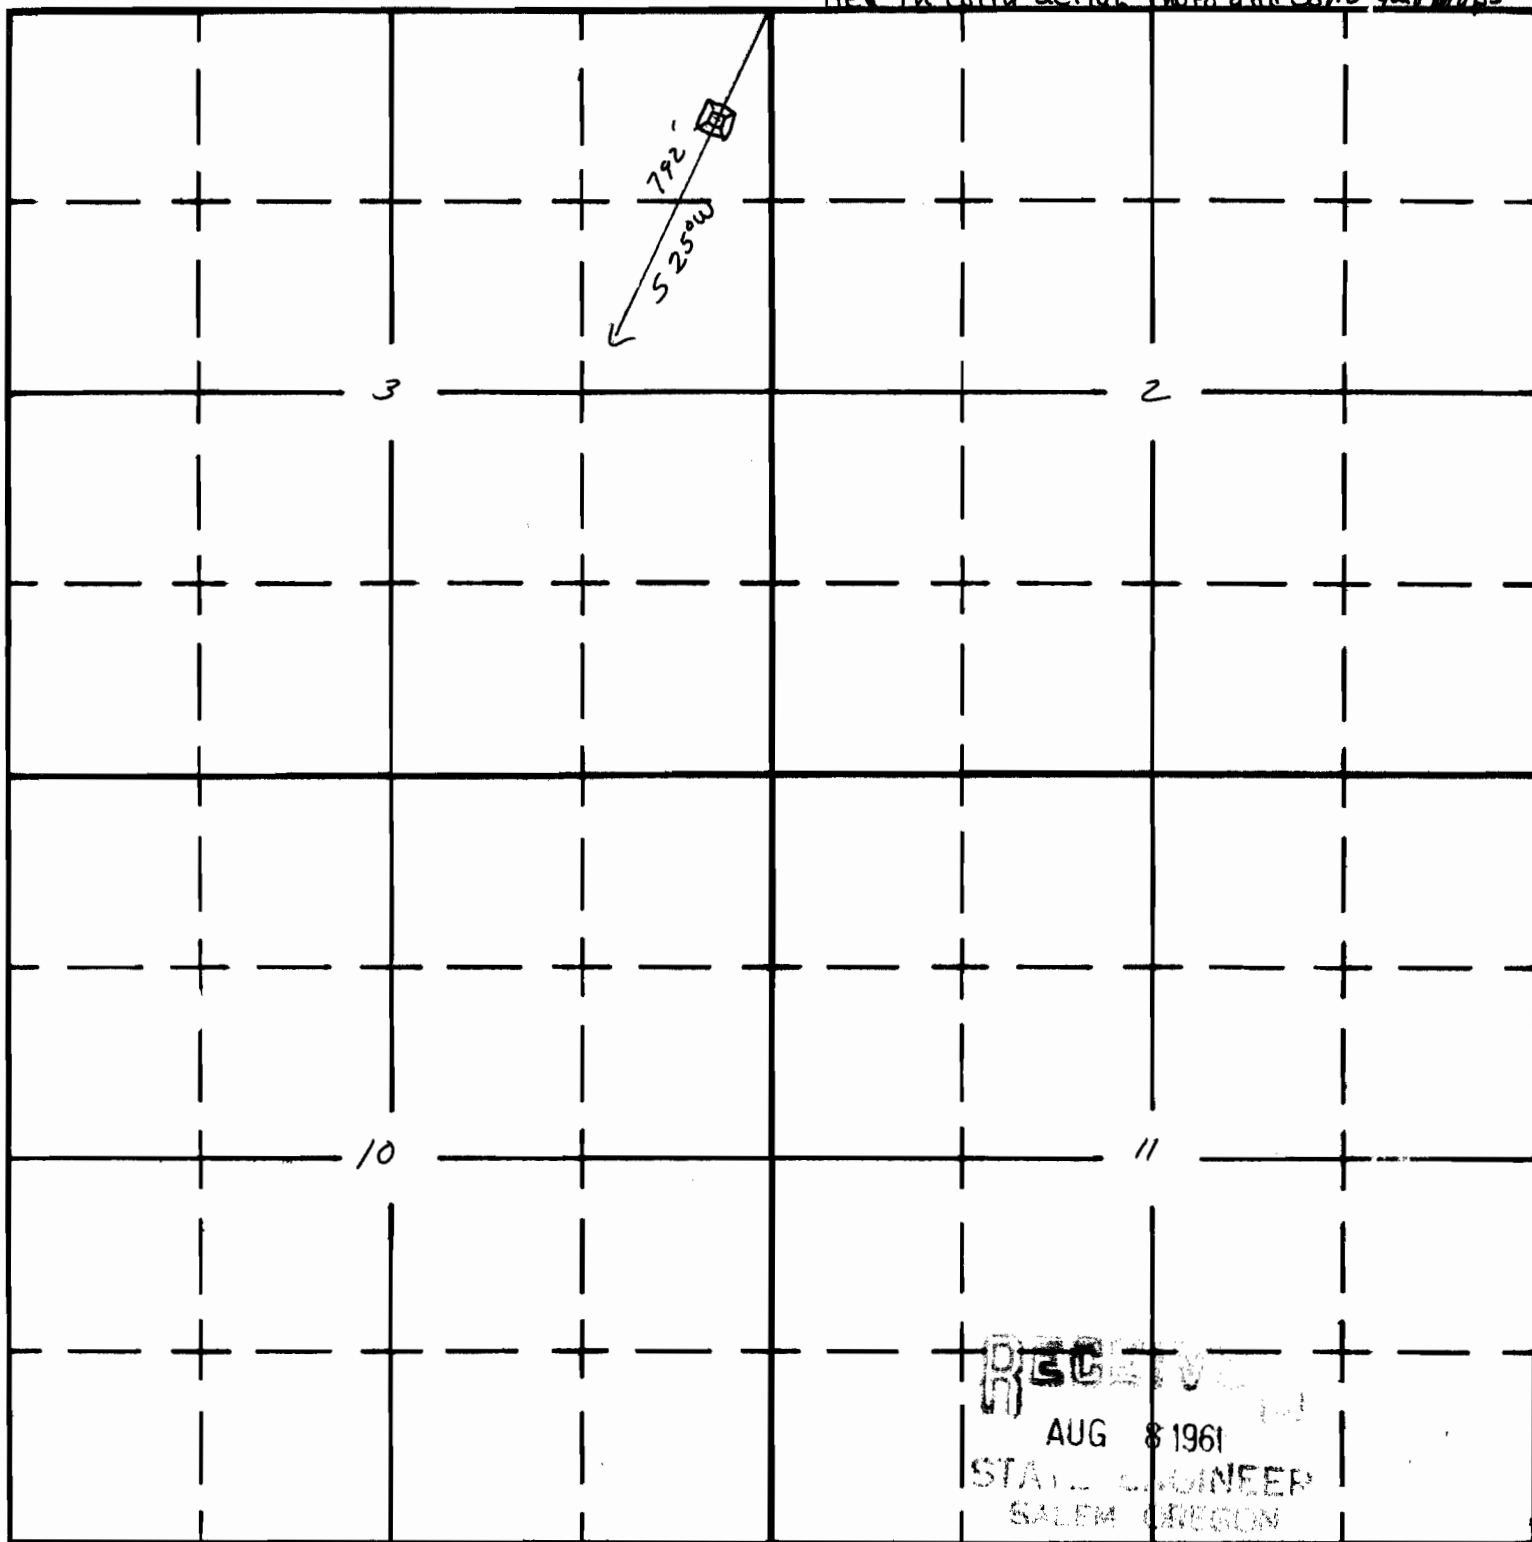

RECEIVED
AUG 8 1961
STATE ENGINEER
SALEM OREGON

APPLICATION No. R-36513
PERMIT No. R-4233