


Form AI-187
March 1961

UNITED STATES
DEPARTMENT OF THE INTERIOR
BUREAU OF LAND MANAGEMENT

SECTION
27
NE 1/4 NE 1/4

Oregon State Water Filings

TOWNSHIP 38S, RANGE 28E, W. M.

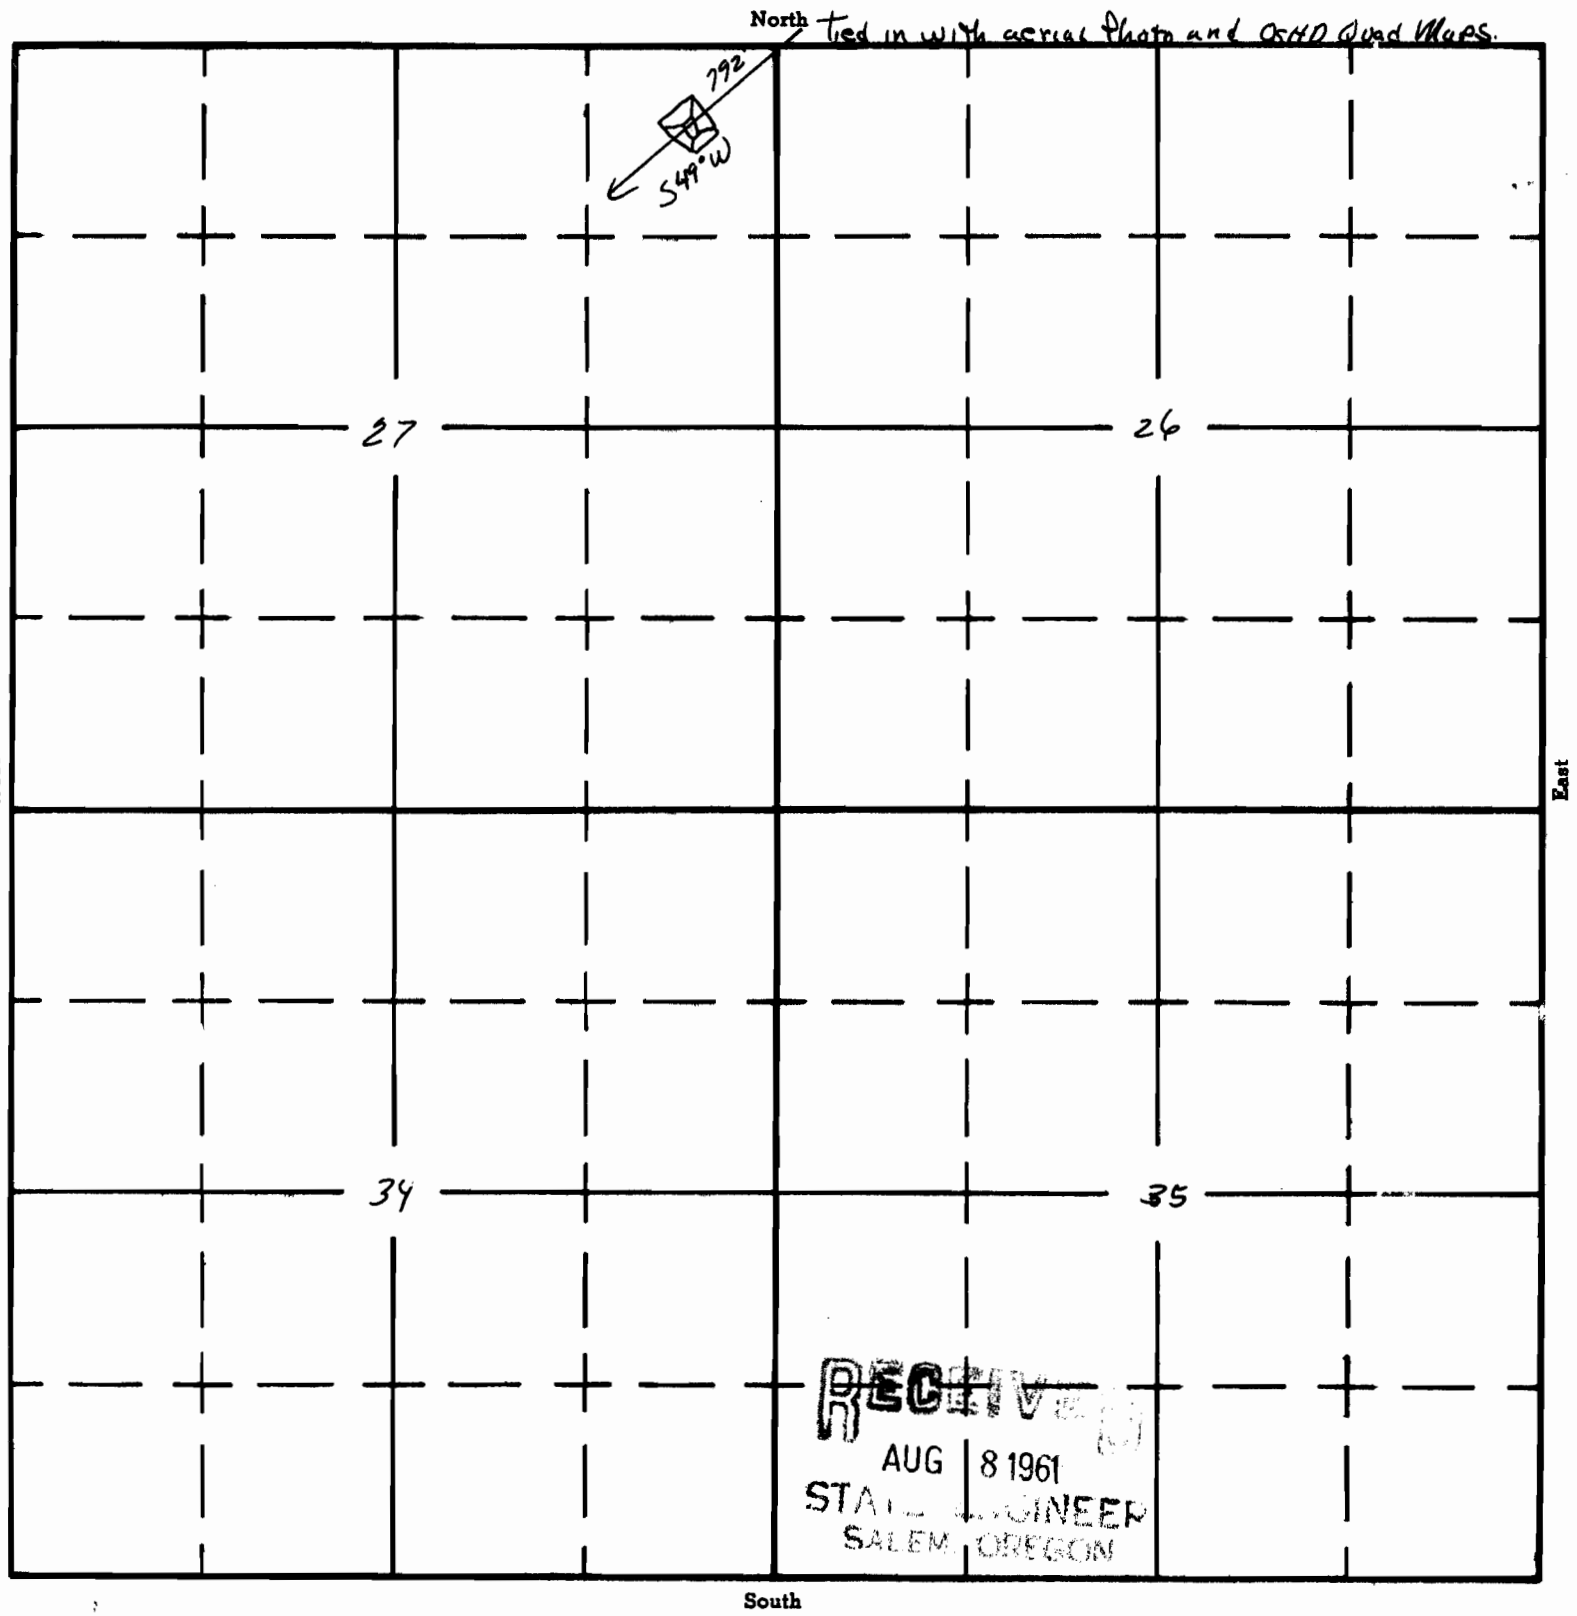

APPLICATION No. R-36514
PERMIT No. R-4234