


UNITED STATES
DEPARTMENT OF THE INTERIOR
BUREAU OF LAND MANAGEMENT

SECTION 28
SW 1/4 NW 1/4

Oregon State Water Filings

TOWNSHIP 38S, RANGE 29E, W. M.

North *Tied in with aerial photo and OS&N Quad Maps.*

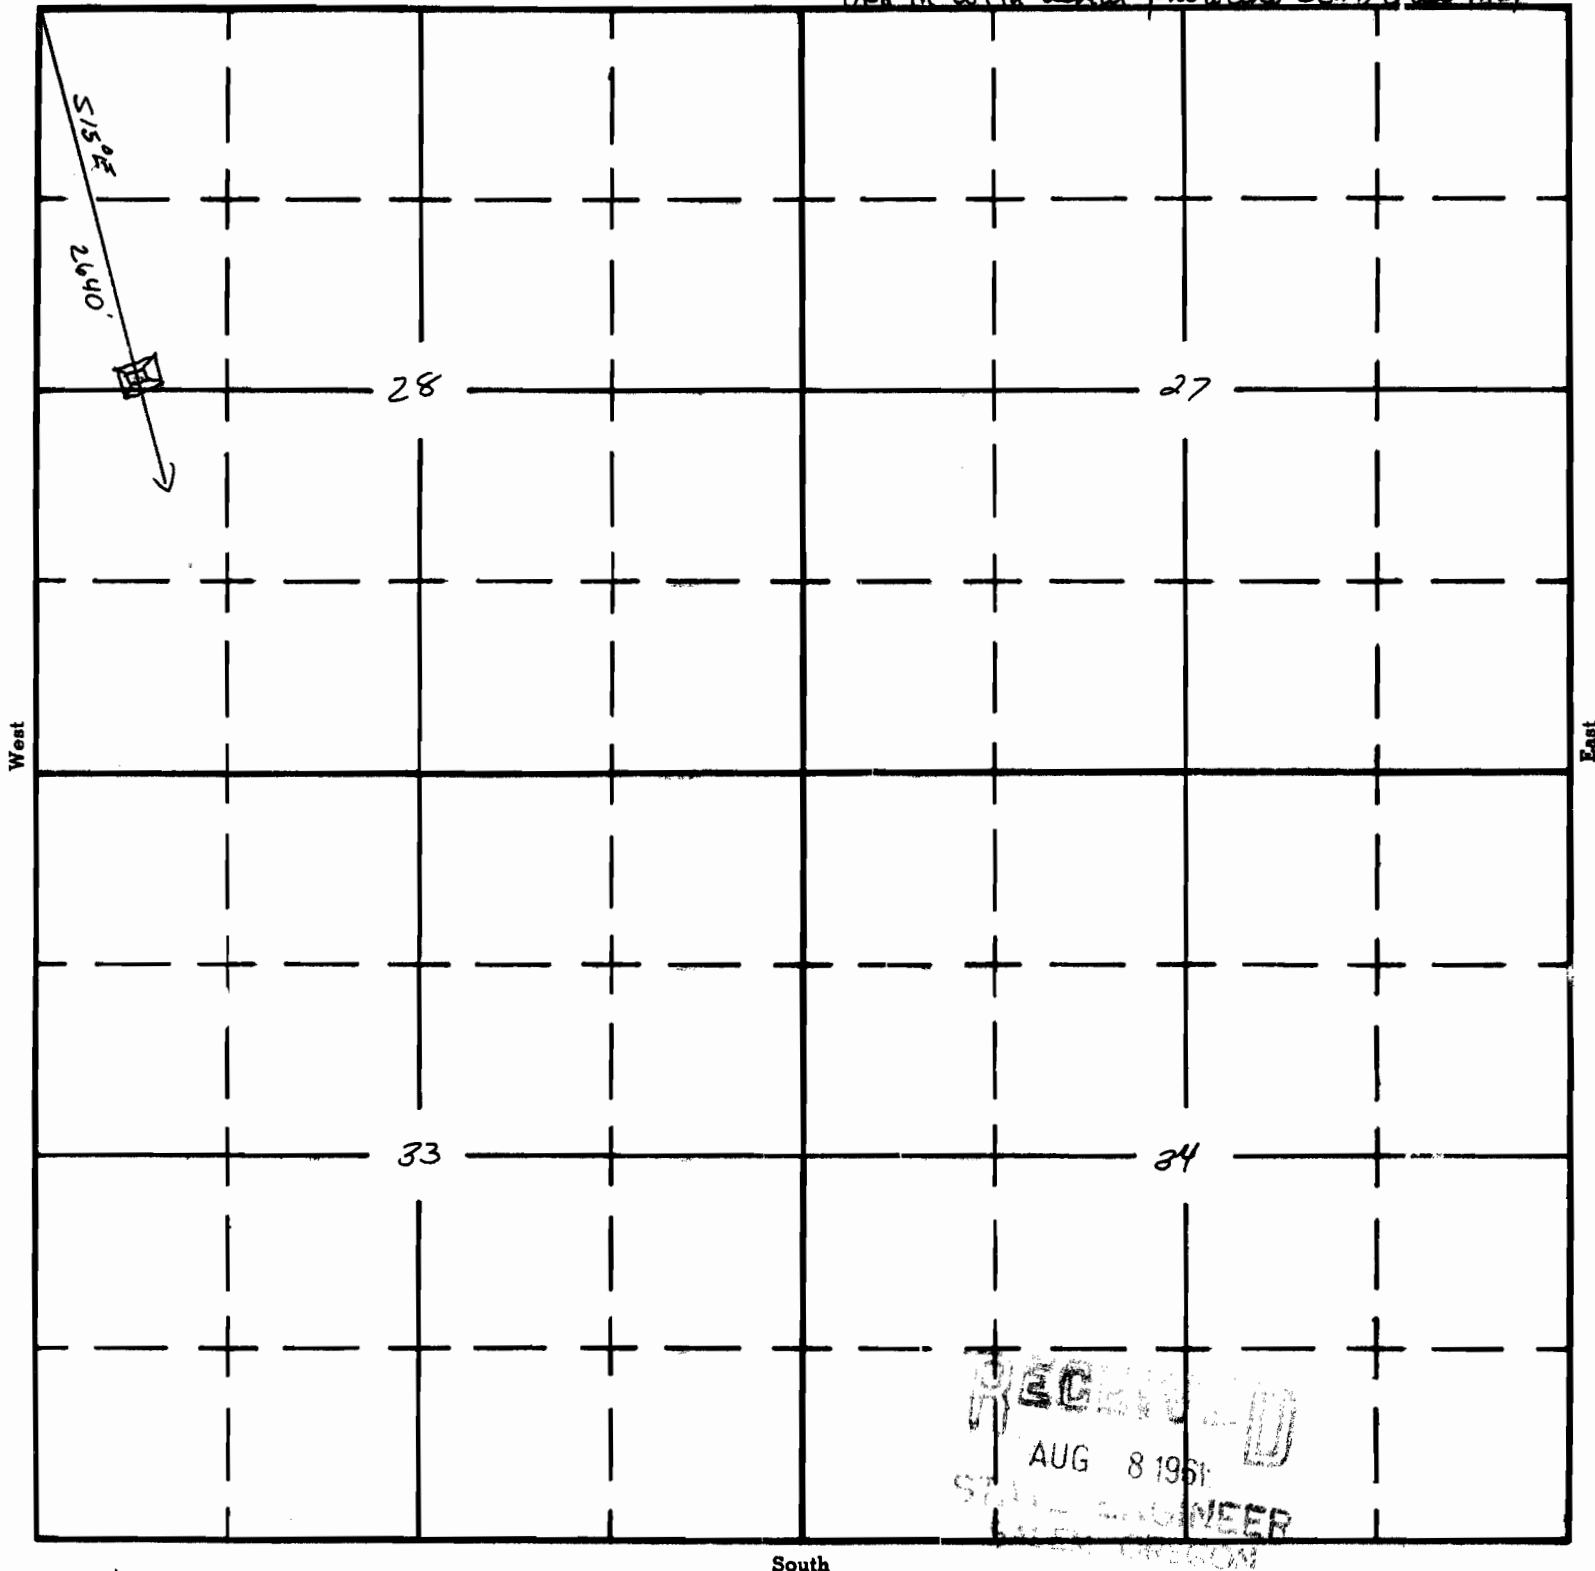

APPLICATION No. **R-36515**
PERMIT No. **R-4235**