

Form A1-187
March 1961


UNITED STATES
DEPARTMENT OF THE INTERIOR
BUREAU OF LAND MANAGEMENT

SECTION 33
NE 1/4 SE 1/4

Oregon State Water Filings

TOWNSHIP 38S, RANGE 29E, W. M.

North Tied in with aerial photo and ASM Quad Maps.

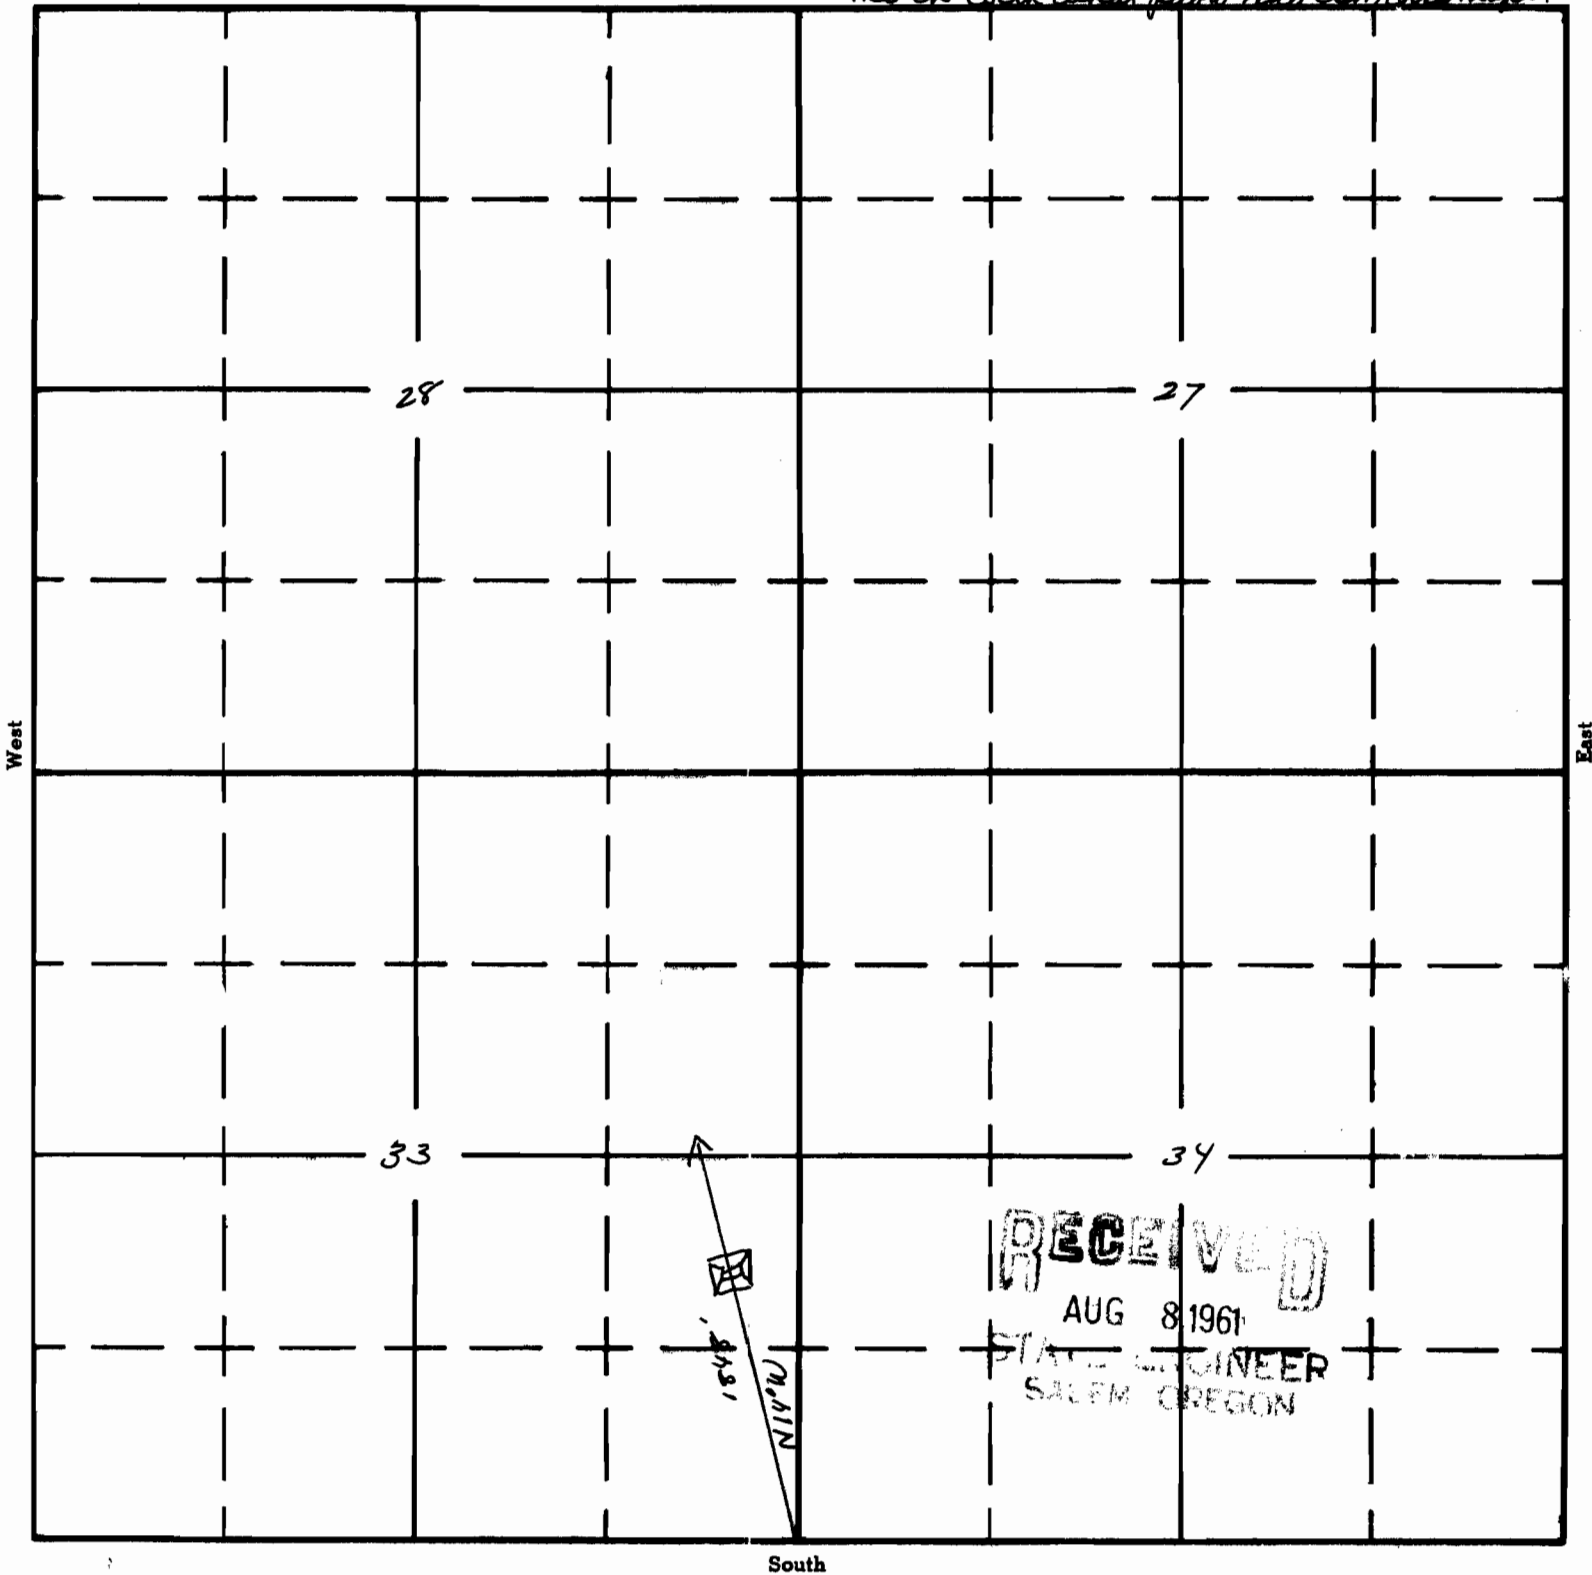

RECEIVED
AUG 8 1961
STATE ENGINEER
SALEM OREGON

APPLICATION No. R-36516
PERMIT No. R-4236