

UNITED STATES
DEPARTMENT OF THE INTERIOR
BUREAU OF LAND MANAGEMENT

SECTION


24

Oregon State Water Filings

NW 1/4 SE 1/4

TOWNSHIP 40S, RANGE 30E, W. M.

TIED-IN WITH AERIAL PHOTOS ^{North} AND O.S.H.D. QUAD MAPS.

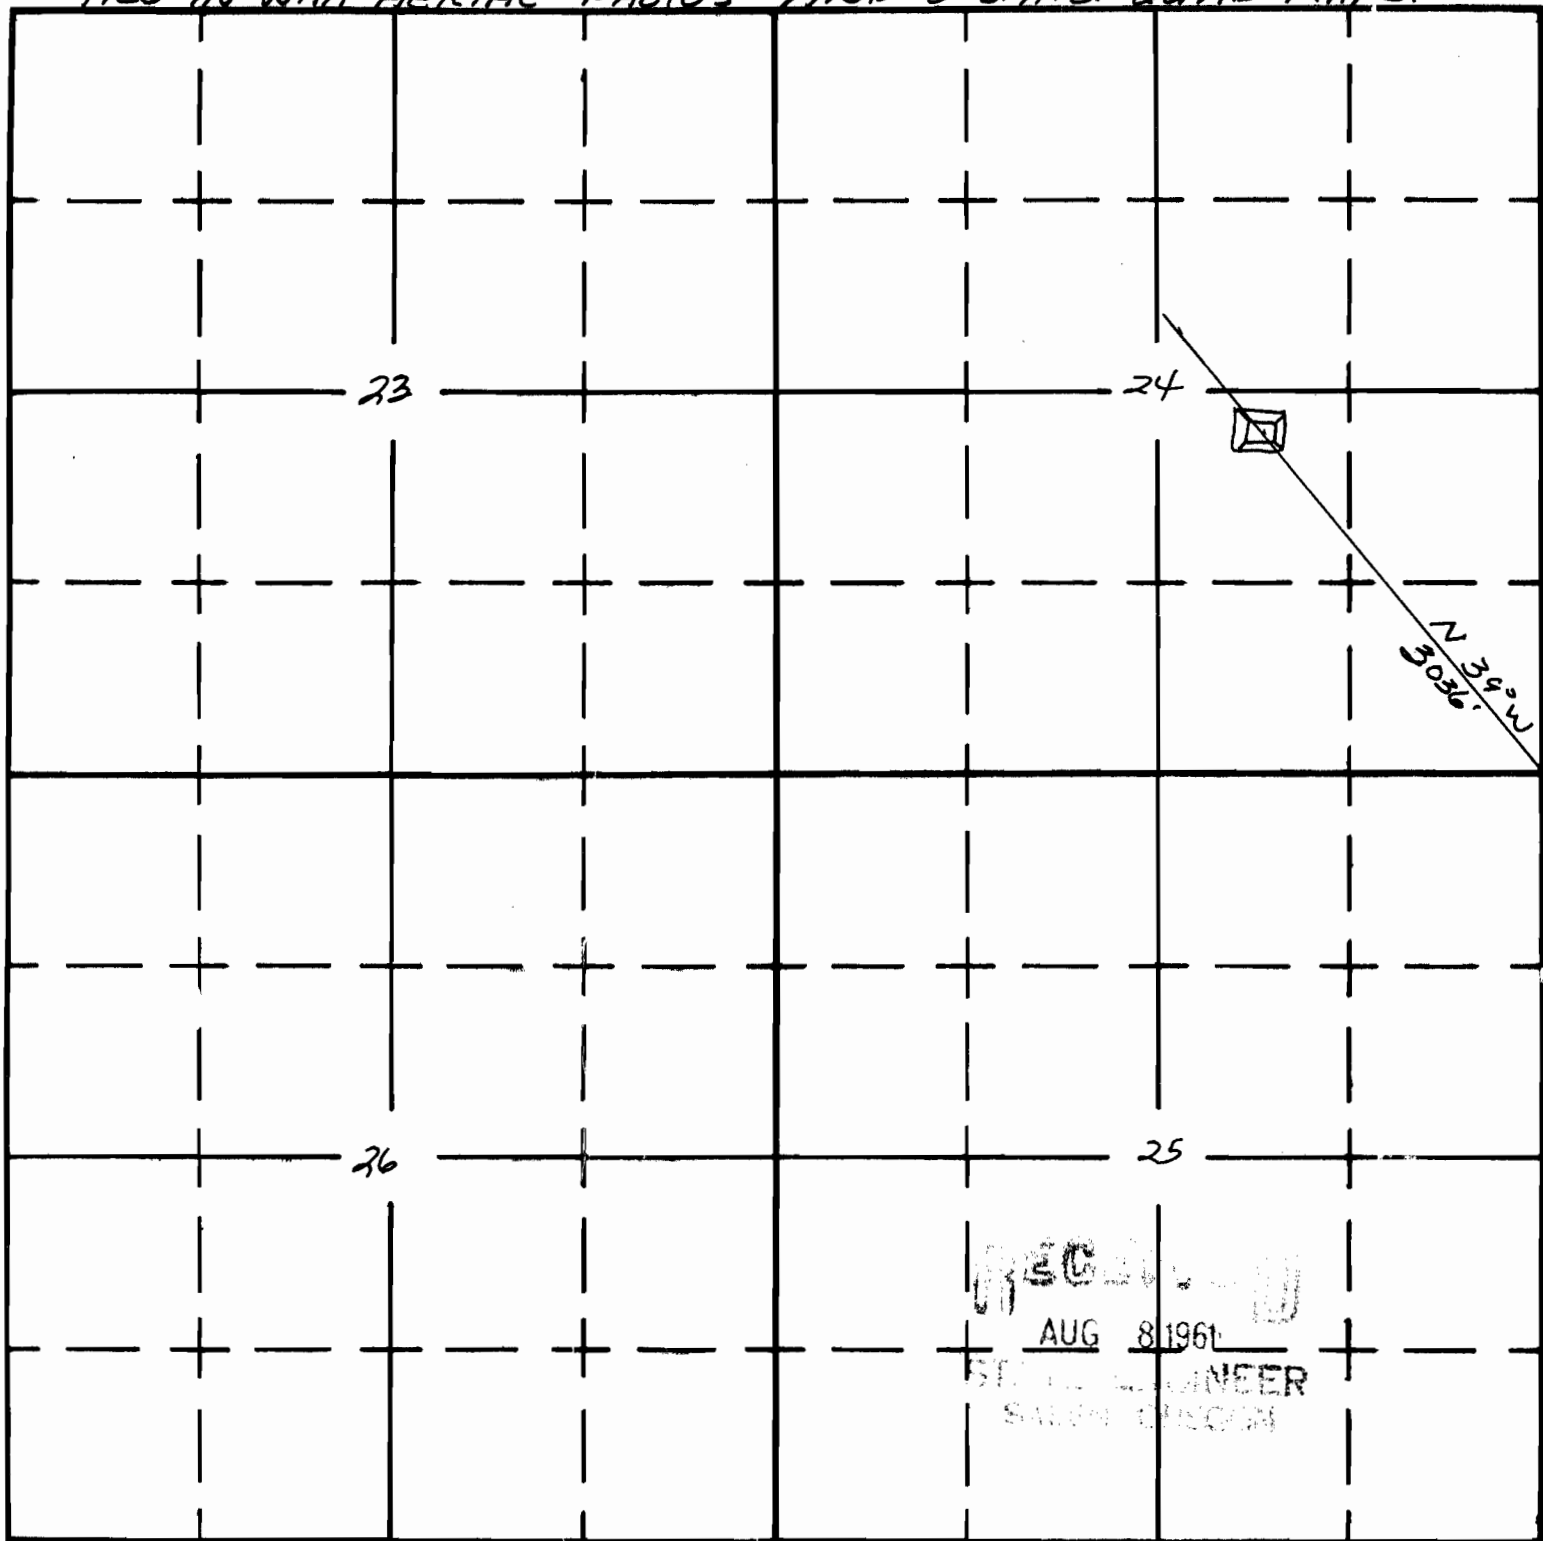

RECEIVED
AUG 8 1961

APPLICATION No. R-36523
PERMIT No. R-4242