

Form AI-187
March 1961

UNITED STATES
DEPARTMENT OF THE INTERIOR
BUREAU OF LAND MANAGEMENT


SECTION

20
NW 1/4 NW 1/4

Oregon State Water Filings

TOWNSHIP 39S, RANGE 30E, W. M.

North Tied in with aerial Photo and USGS Quad Maps

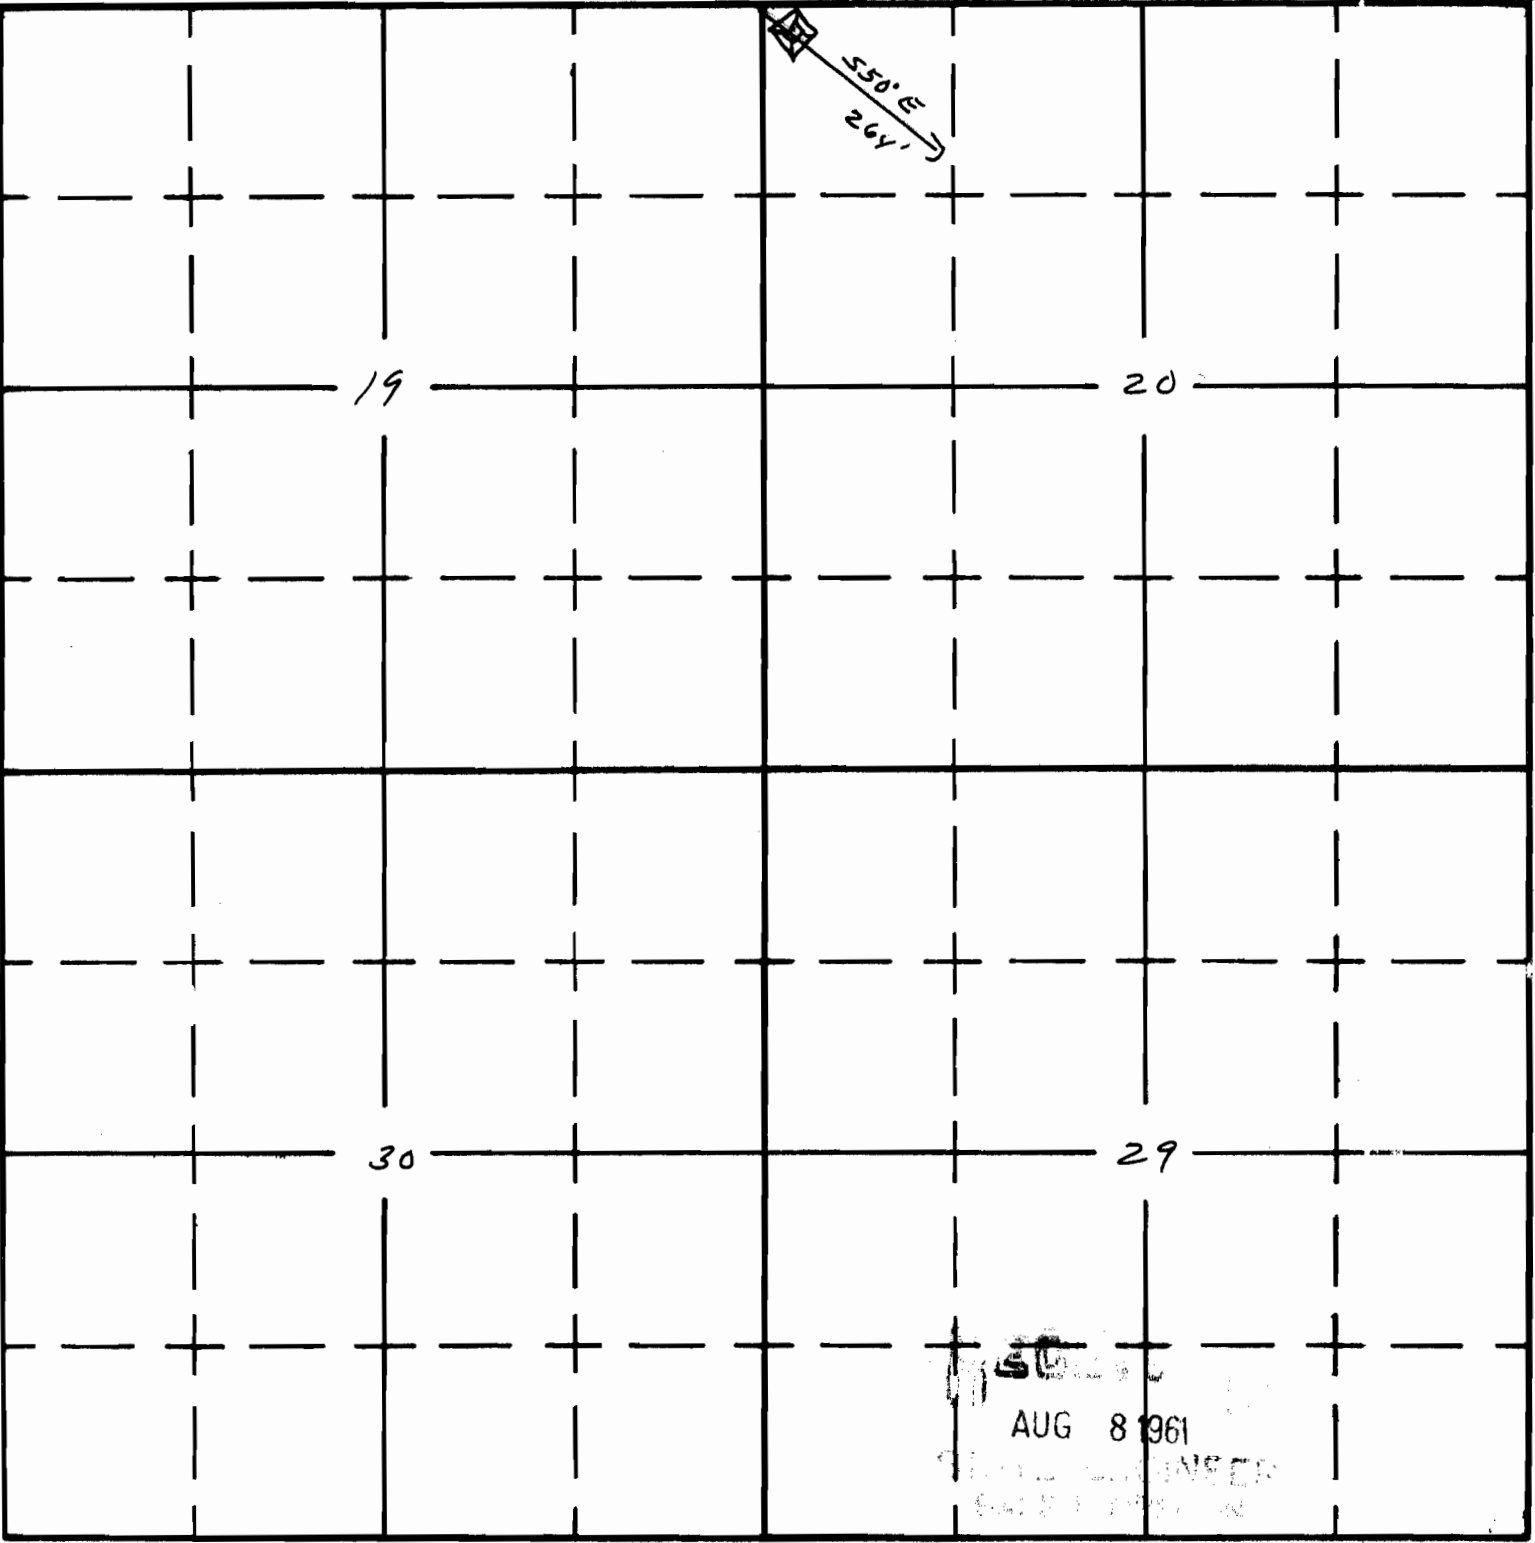

AUG 8 1961

APPLICATION No. **R-36541**
PERMIT No. **R-4249**