

Form A1-187
March 1961

UNITED STATES
DEPARTMENT OF THE INTERIOR
BUREAU OF LAND MANAGEMENT

SECTION


13

Oregon State Water Filings

ME 1/4 SW 1/4

TOWNSHIP 40S, RANGE 31E, W. M.

TIED IN WITH AERIAL PHOTOS ^{North} AND O.S.H.D. QUAD MAPS

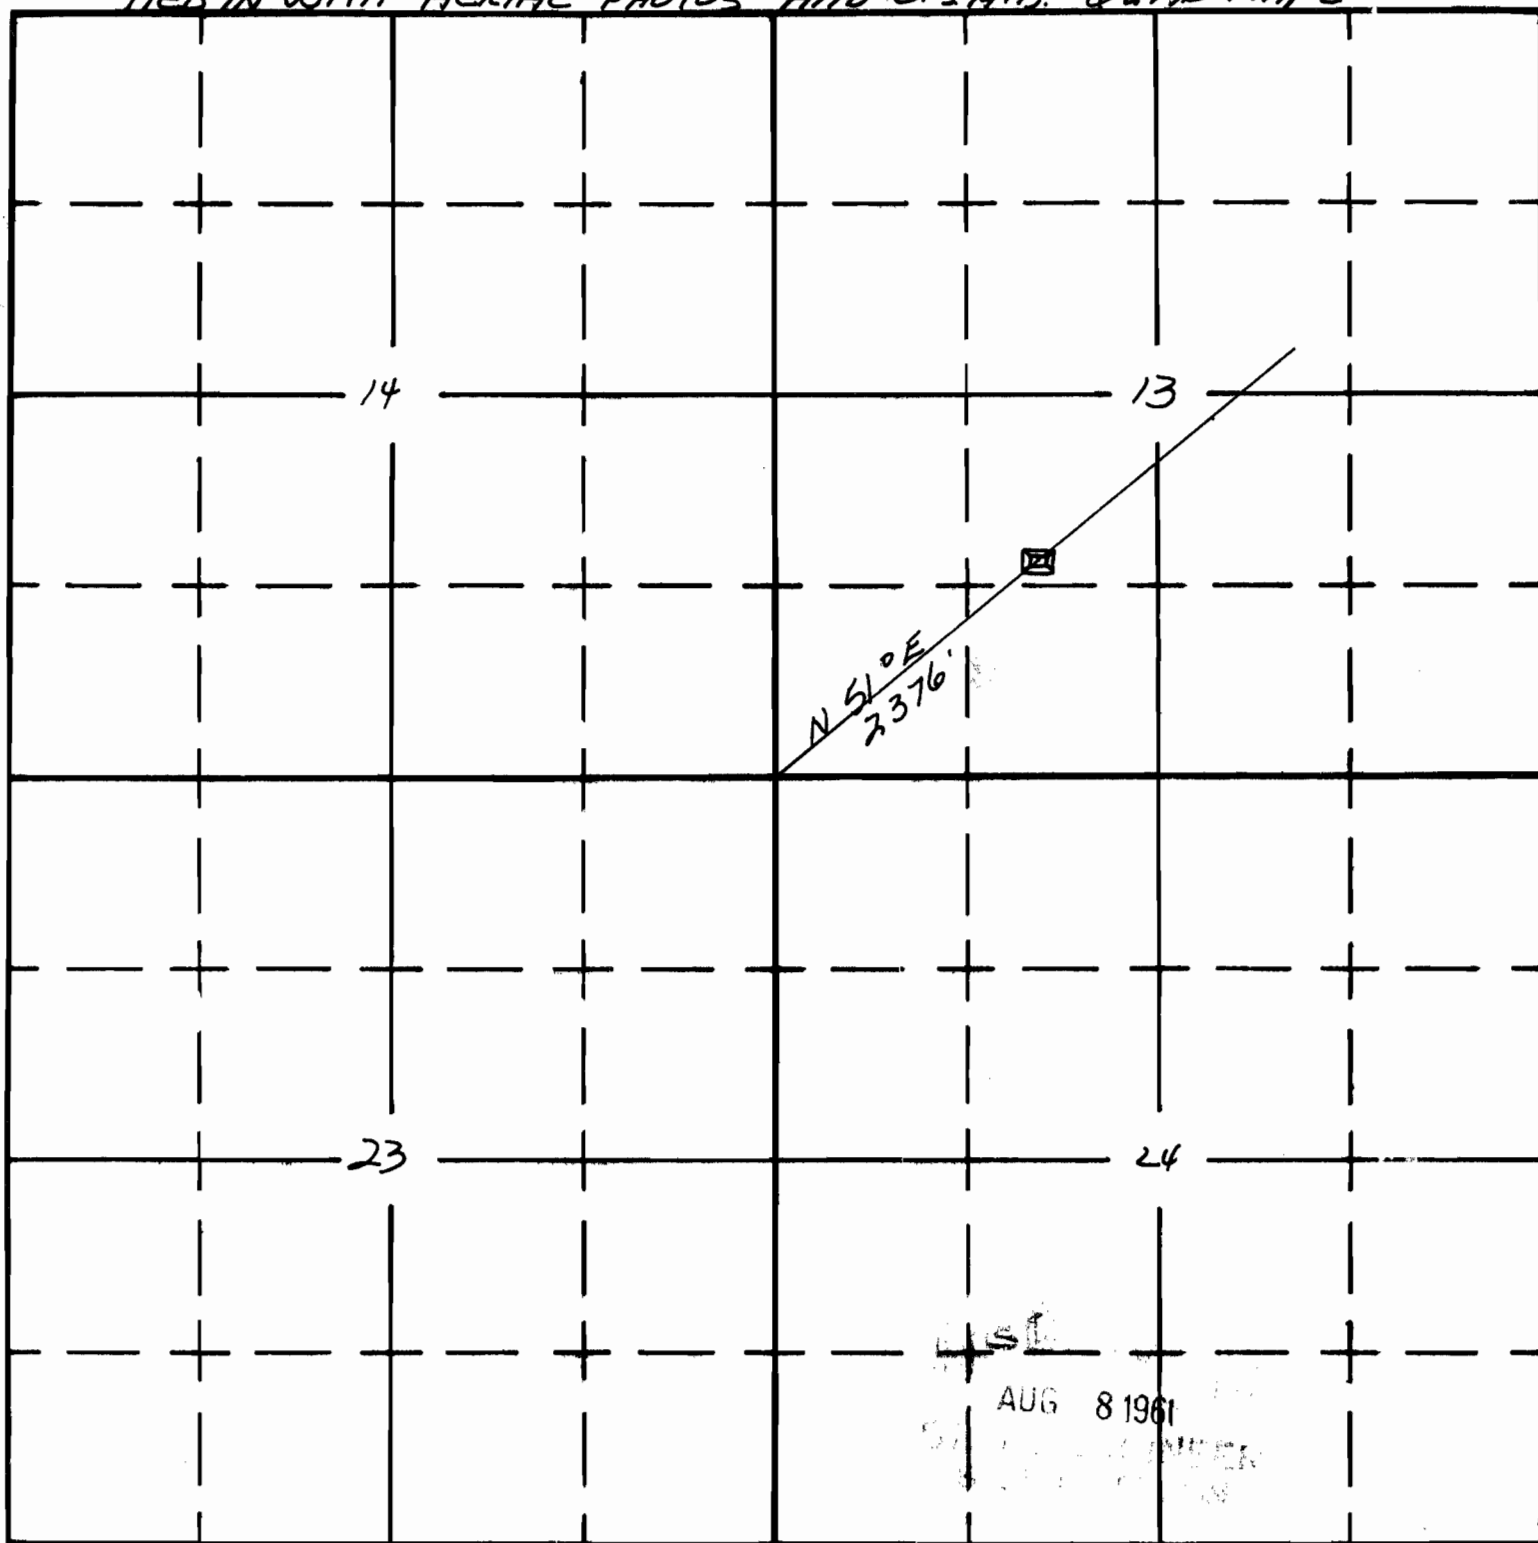

AUG 8 1961

APPLICATION No. R-36575
PERMIT No. R-4254