

UNITED STATES
DEPARTMENT OF THE INTERIOR
BUREAU OF LAND MANAGEMENT


SECTION

S15

Oregon State Water Filings

TOWNSHIP 3/S, RANGE 43E, W. M.

North

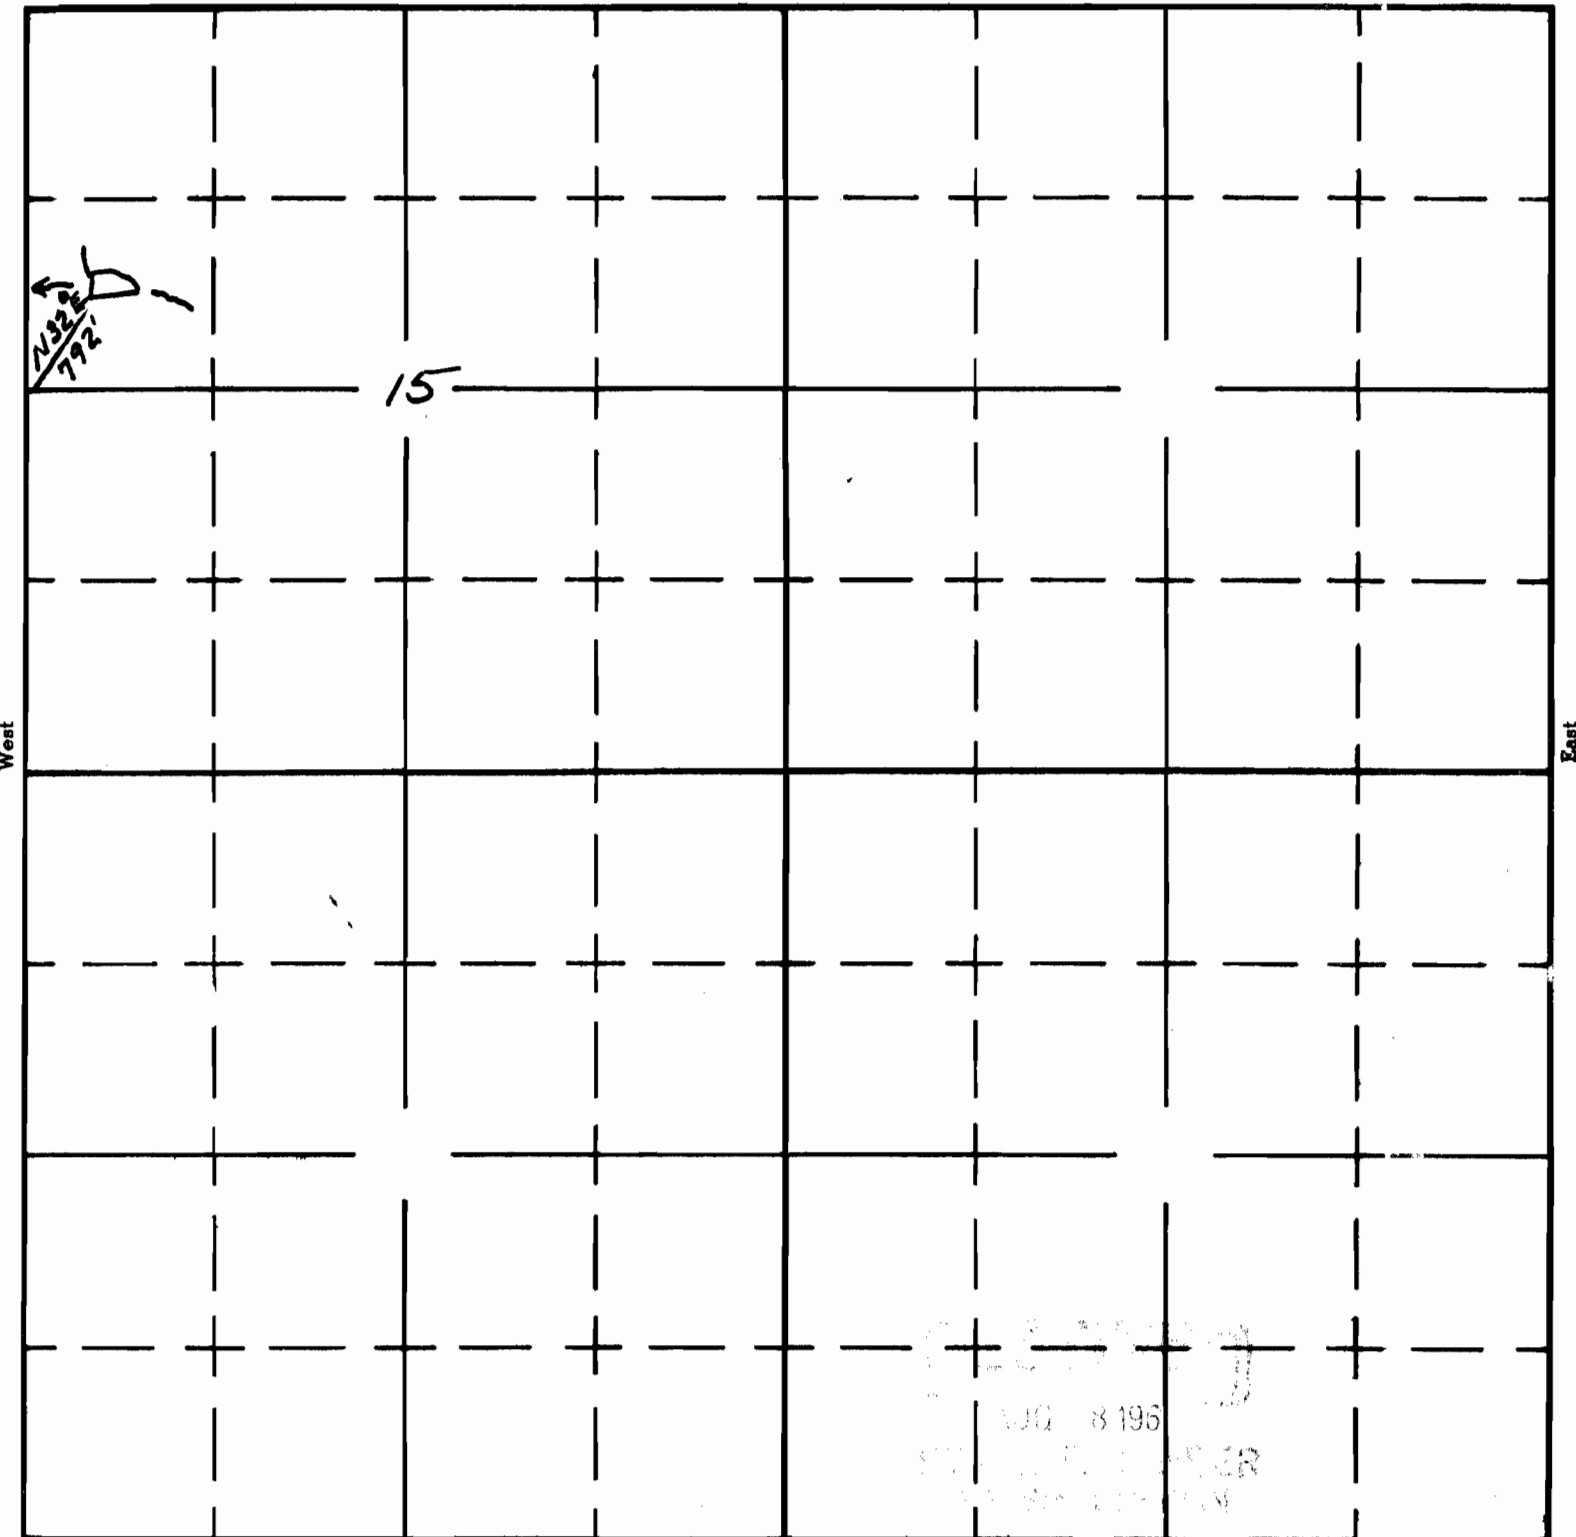

West

East

South

APPLICATION No. R-36624
PERMIT No. R-4259