

UNITED STATES
DEPARTMENT OF THE INTERIOR
BUREAU OF LAND MANAGEMENT

SECTION _____


Oregon State Water Filings

52

TOWNSHIP 29S, RANGE 41E, W. M.

1/2000000 Scale

North

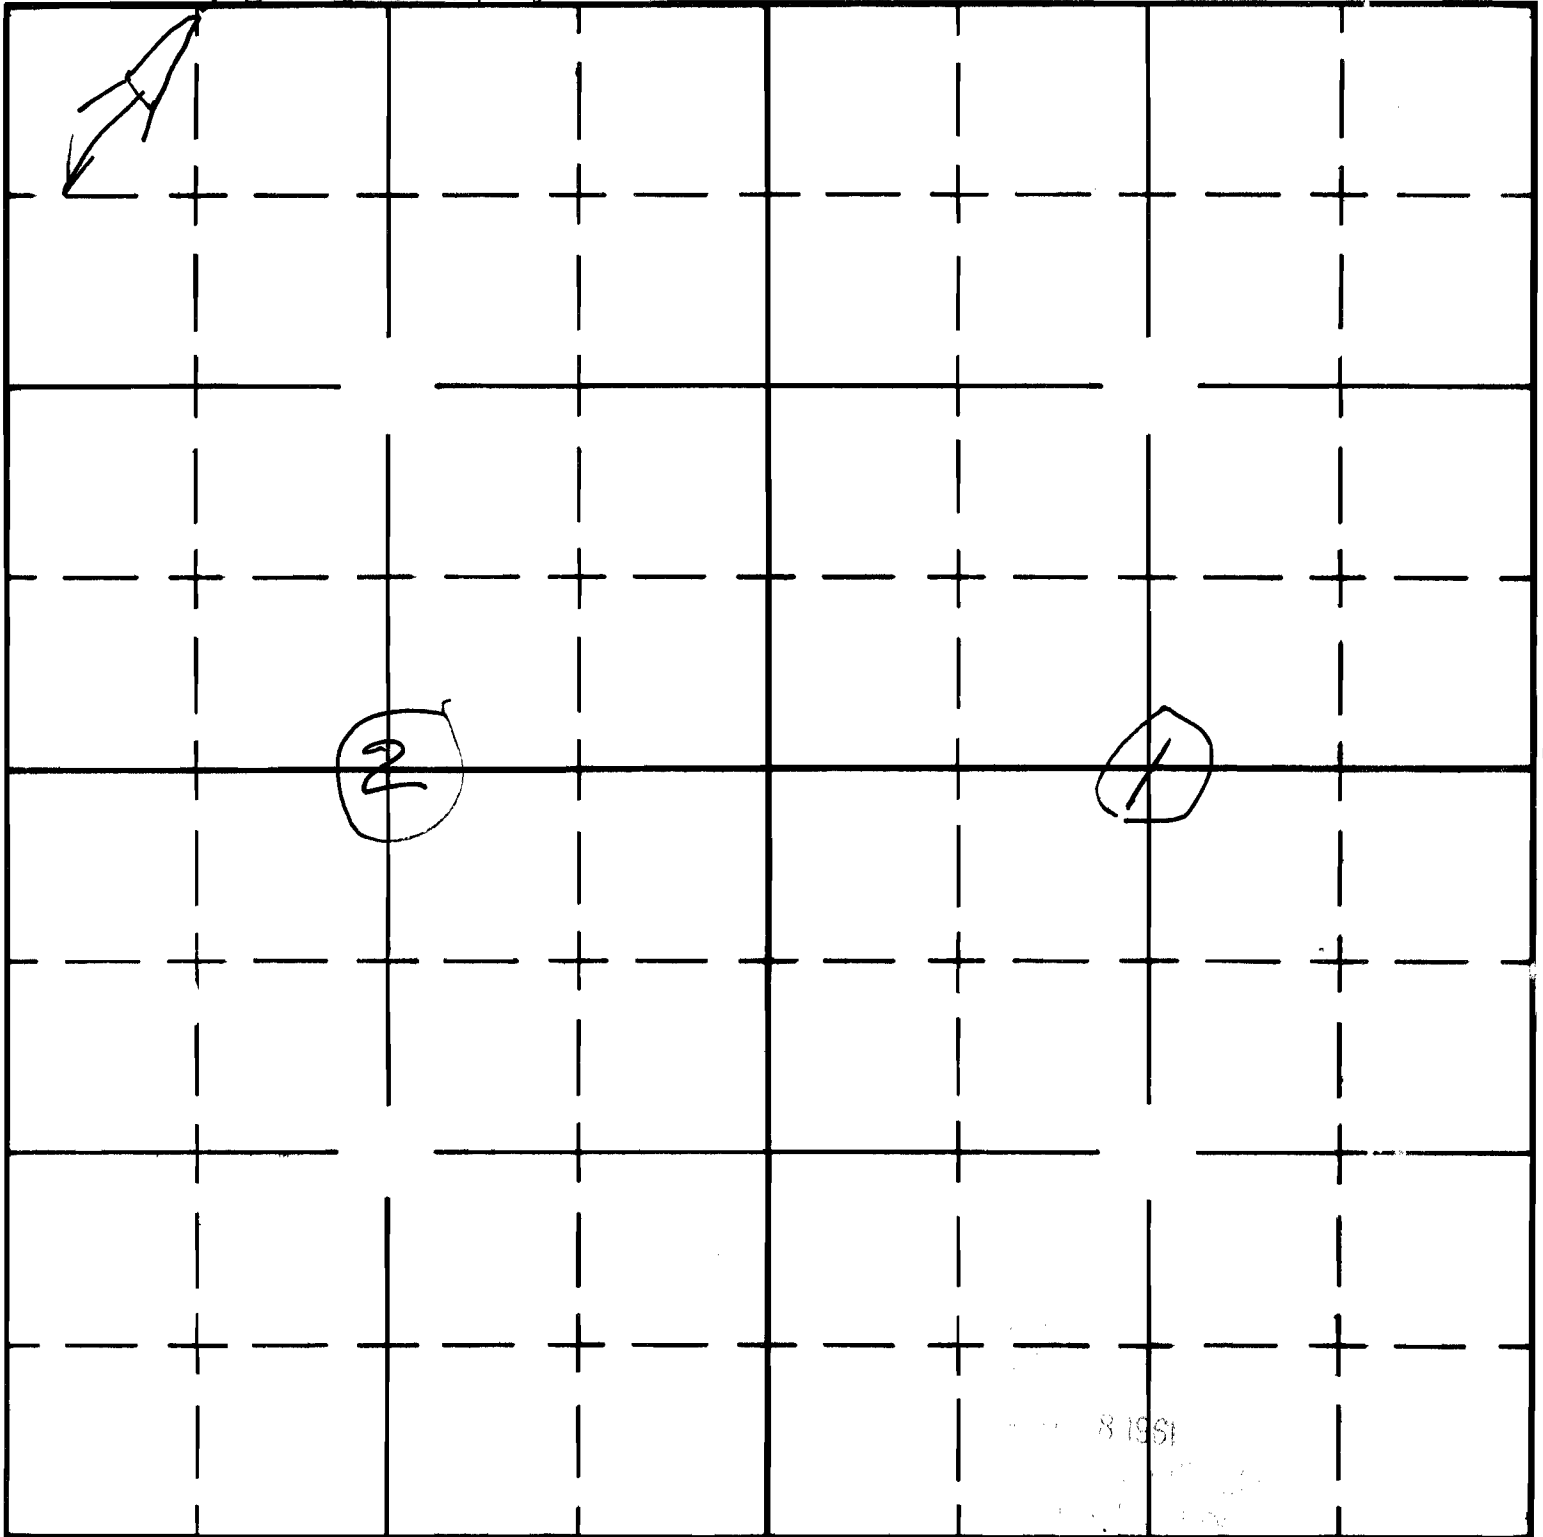

West

East

South

8 1961

APPLICATION No. R-36754
PERMIT No. R-4315