

UNITED STATES  
DEPARTMENT OF THE INTERIOR  
BUREAU OF LAND MANAGEMENT

SECTION


17


NW 1/4 NE 1/4

TOWNSHIP T-41S, RANGE 26E, W. M.

North

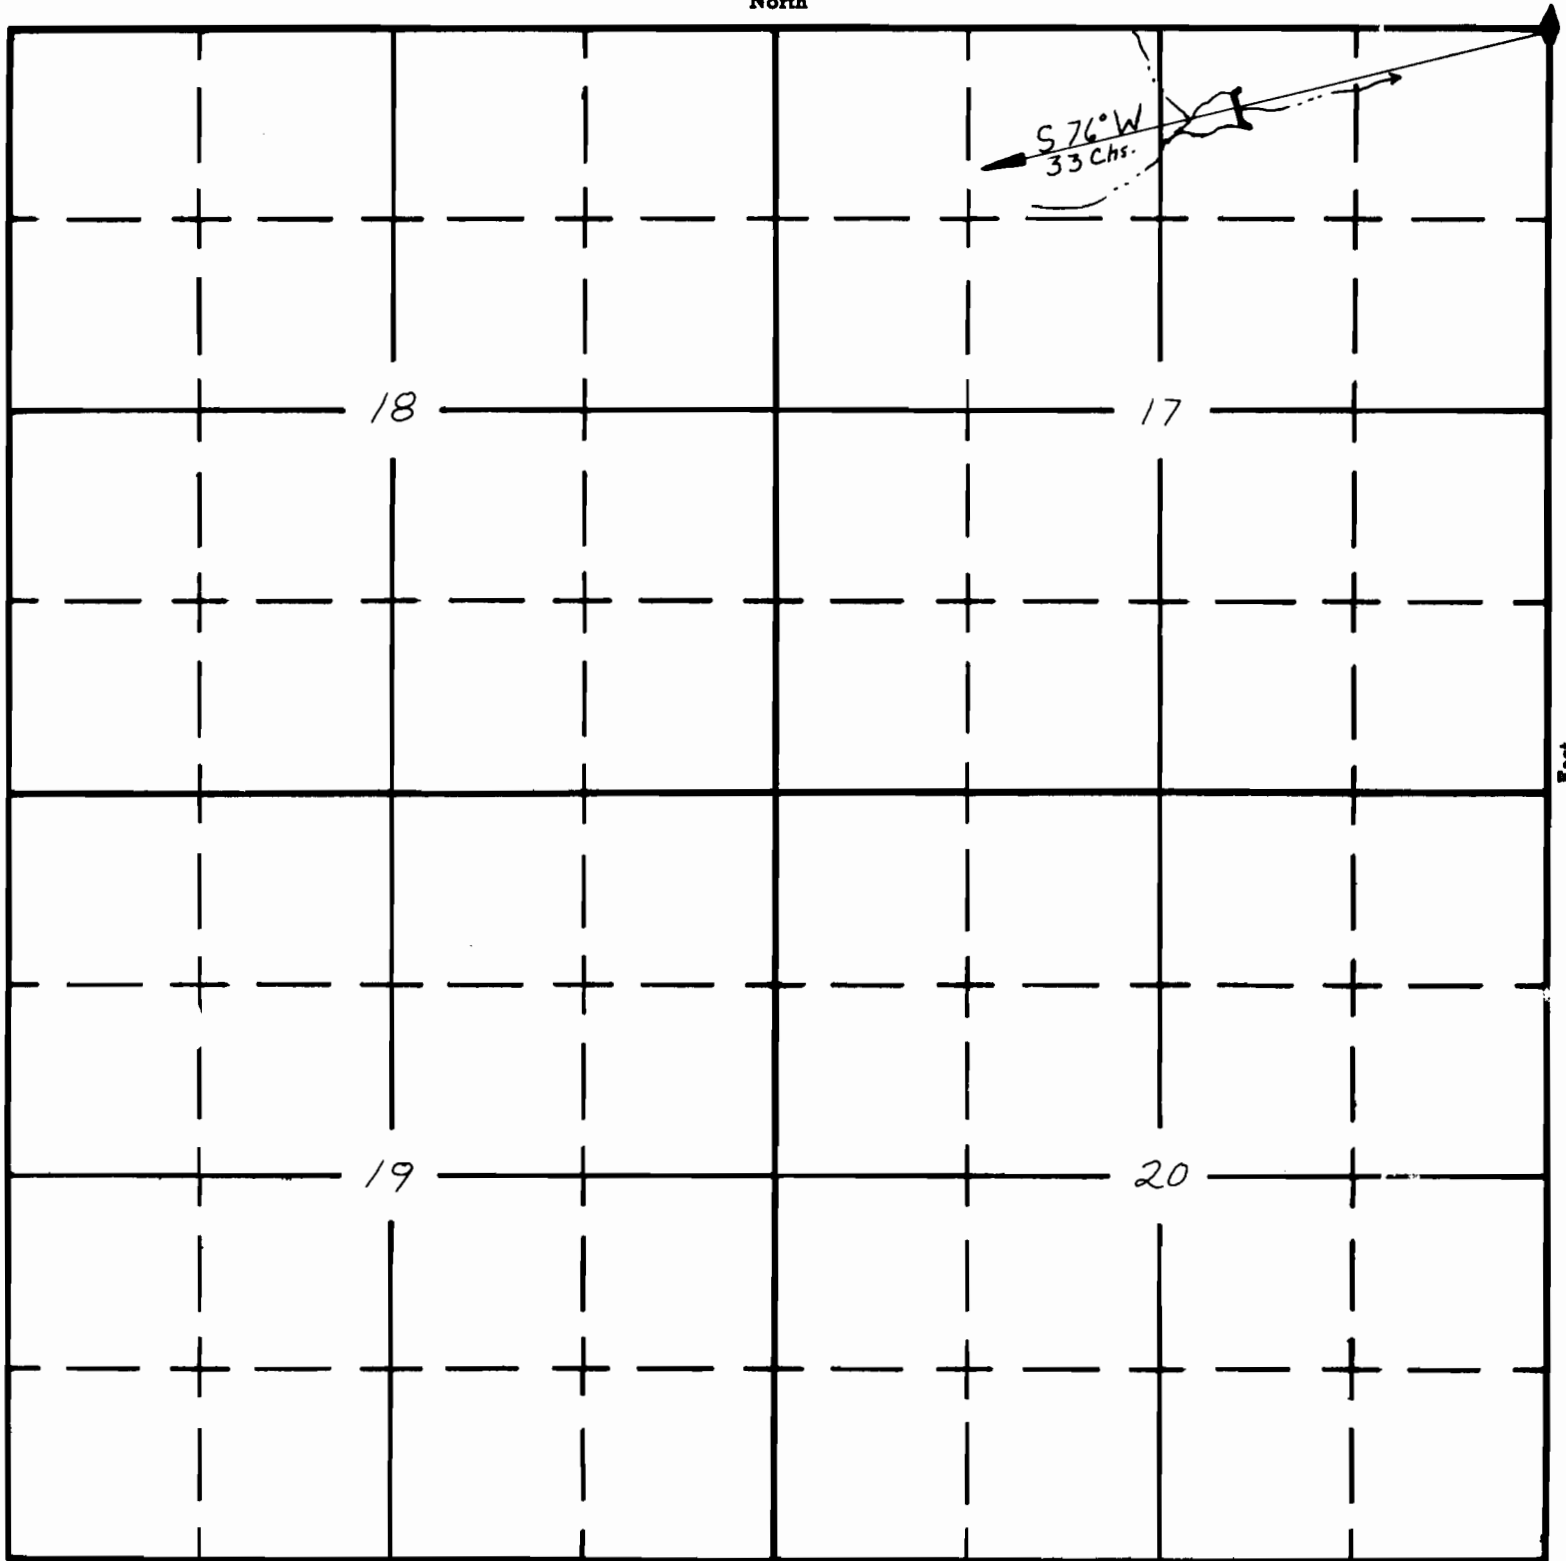

*Festuca Res.*

01-R-245

South

APPLICATION No. R-38591  
PERMIT No. R-4346