


rm A1-187
rch 1961

UNITED STATES
DEPARTMENT OF THE INTERIOR
BUREAU OF LAND MANAGEMENT

R. 4347
63000

CTION 13 **Oregon State Water Filings**

NW 1/4 NE 1/4 TOWNSHIP 41S, RANGE 25E, W. M.

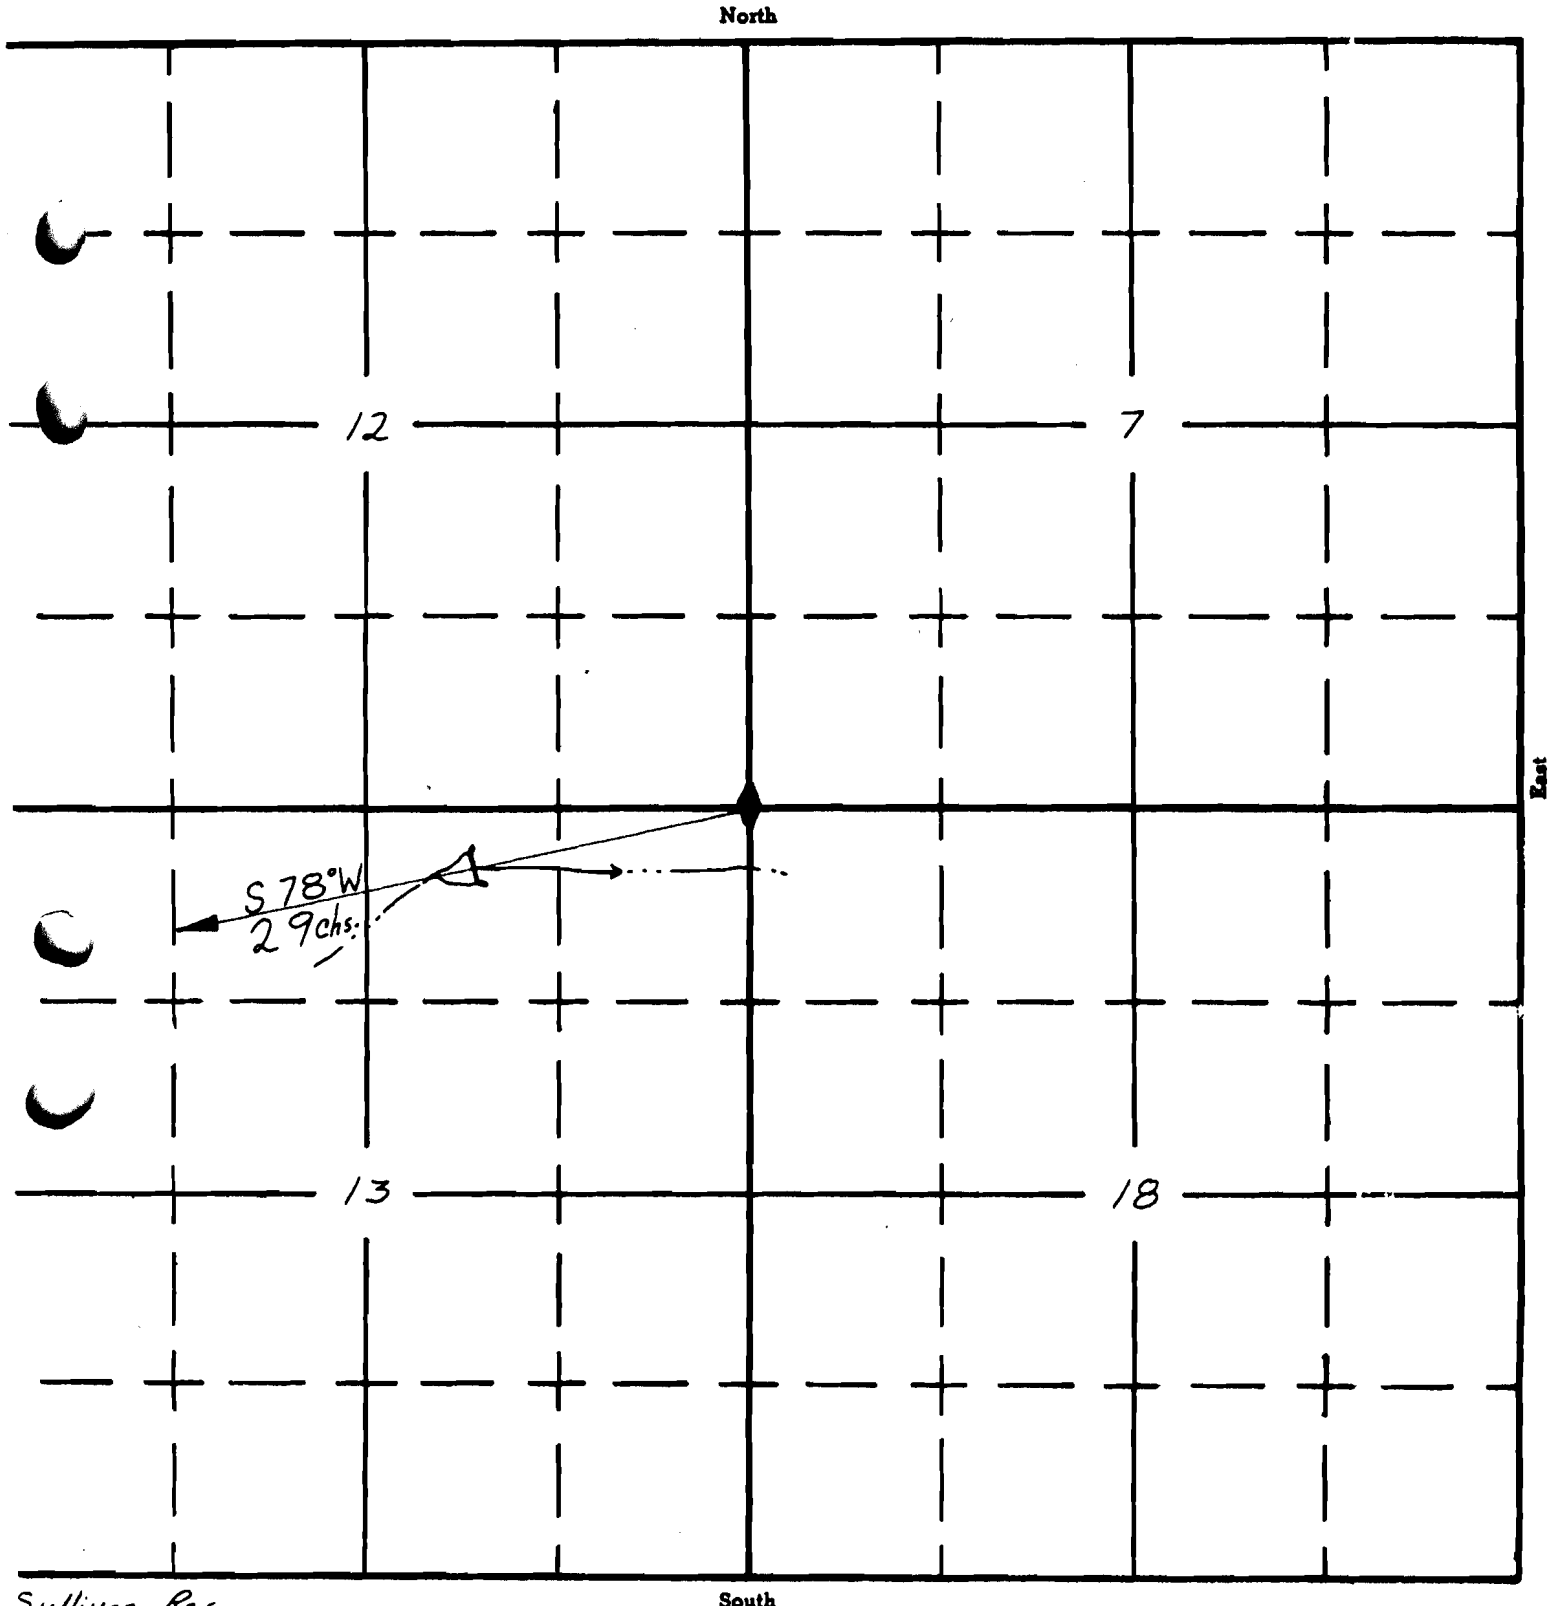

Sullivan Res.
11-R-240

APPLICATION No. R-38592
PERMIT No. R-4347