

Form AI-187
March 1961

UNITED STATES
DEPARTMENT OF THE INTERIOR
BUREAU OF LAND MANAGEMENT

SECTION


8

Oregon State Water Filings

NW 1/4 SW 1/4

TOWNSHIP 41S, RANGE 26E, W. M.

North

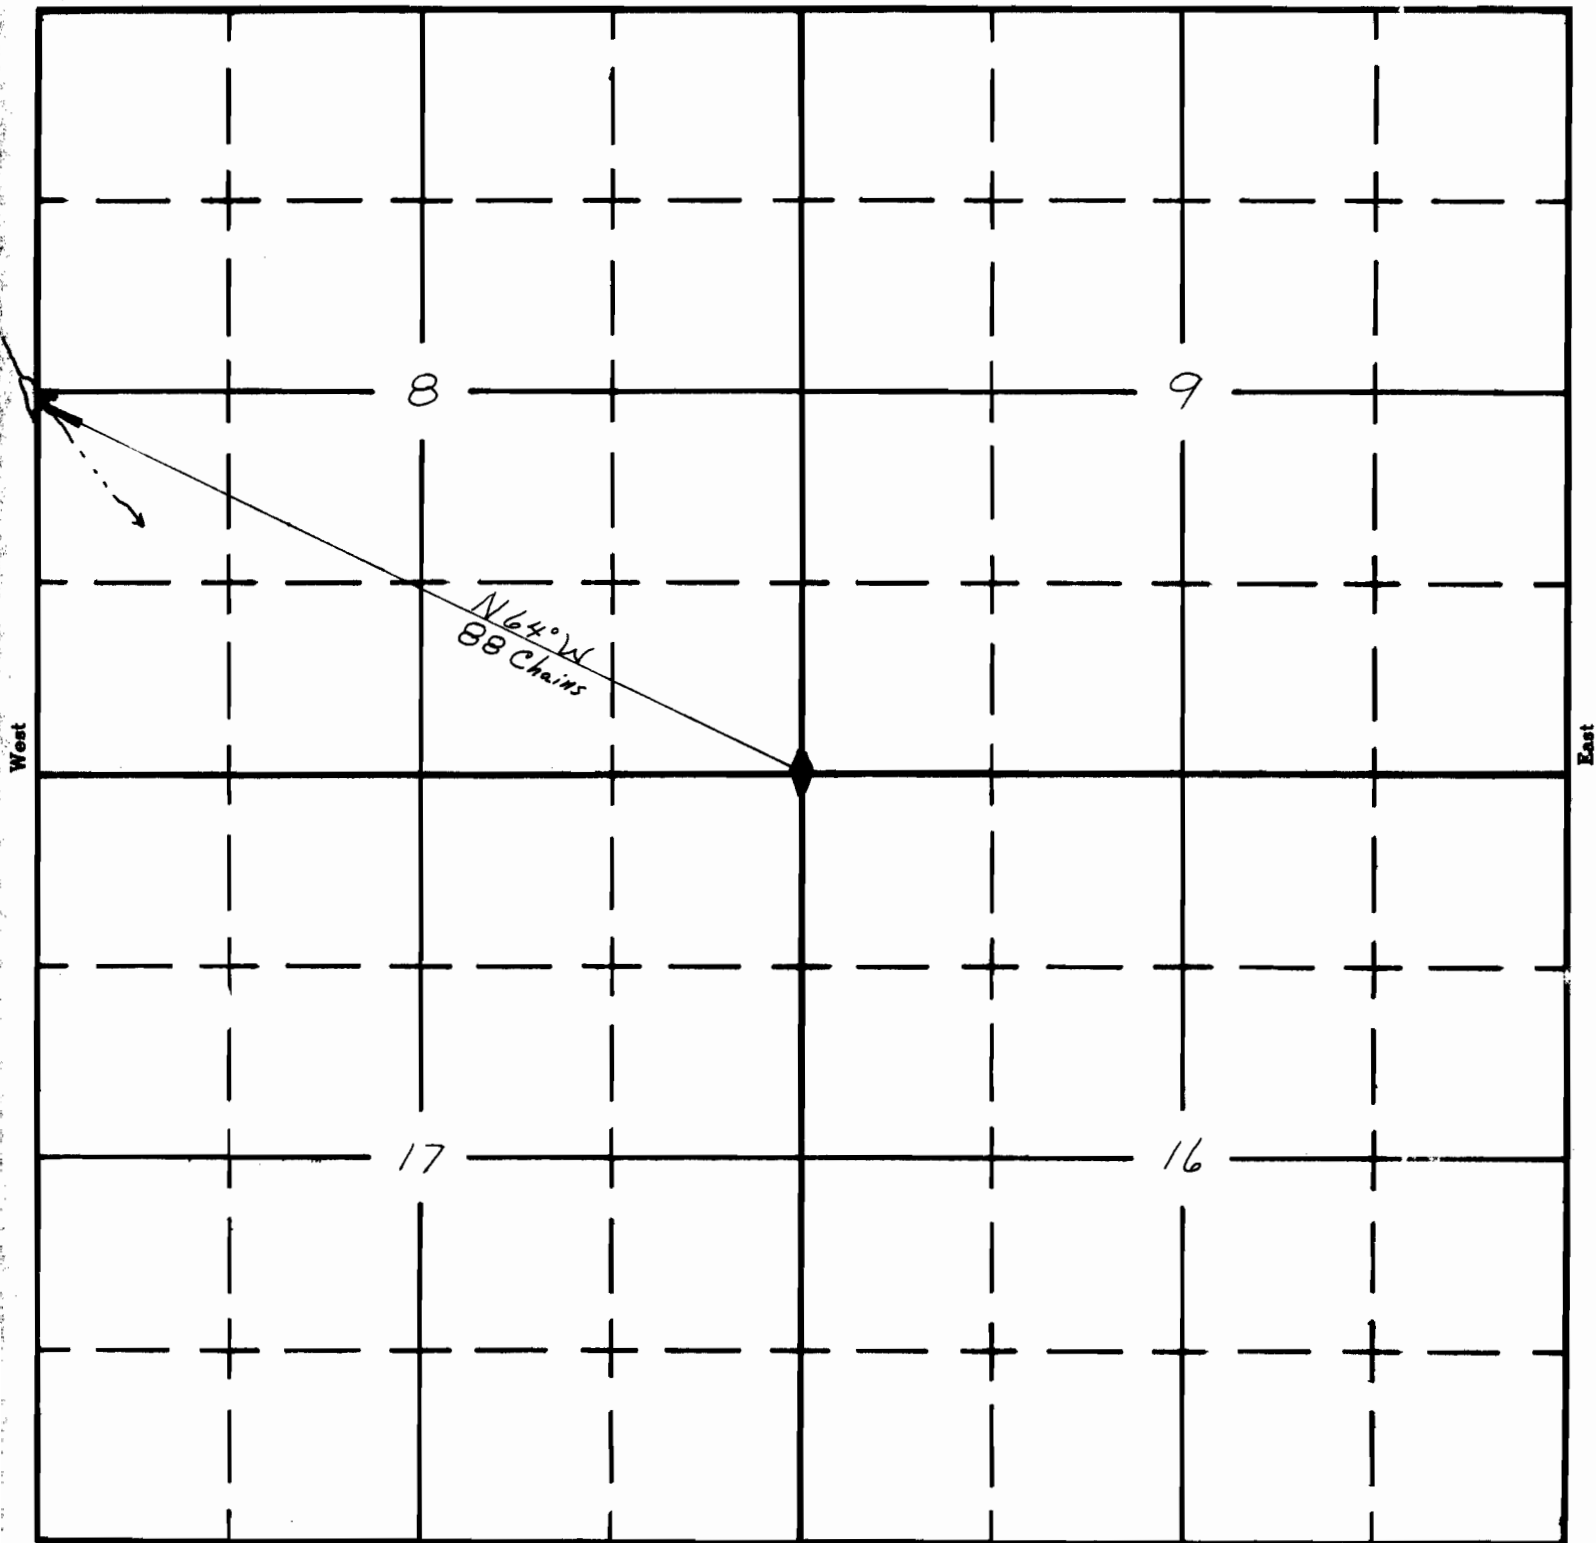

1/4 Corner Reservoir
01-R-254

South

APPLICATION No. R-38598
PERMIT No. R-4351