

Form A1-187
March 1961


UNITED STATES
DEPARTMENT OF THE INTERIOR
BUREAU OF LAND MANAGEMENT

SECTION

Oregon State Water Filings

TOWNSHIP 40-5, RANGE 2-E, W. M.

North

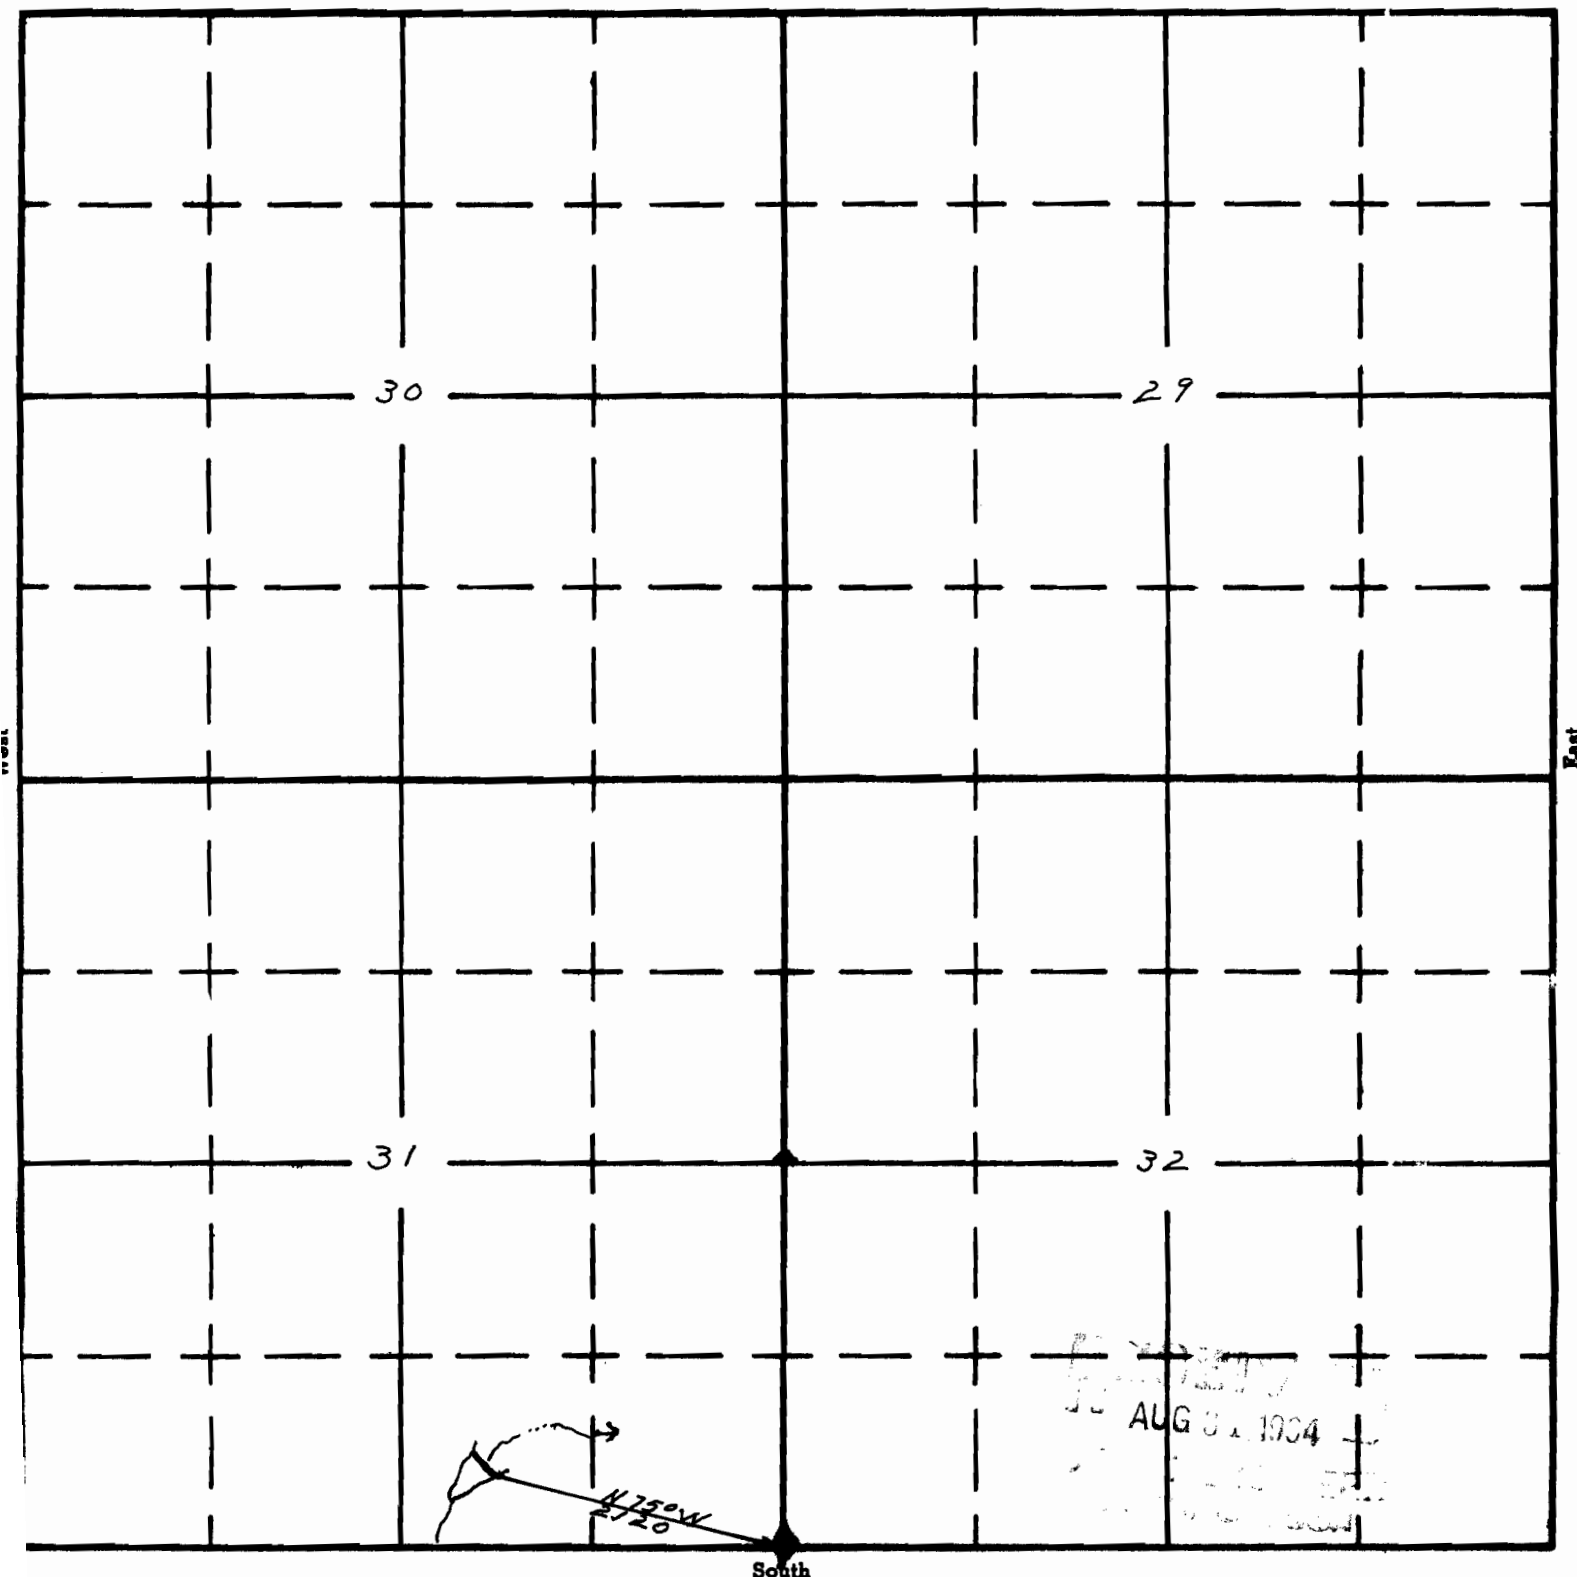

South

APPLICATION No. R-40326
PERMIT No. R-4362