

Form AI-187
March 1961

UNITED STATES
DEPARTMENT OF THE INTERIOR
BUREAU OF LAND MANAGEMENT


SECTION

NE $\frac{1}{4}$, SE $\frac{1}{4}$
SEC. 15

Oregon State Water Filings

TOWNSHIP 37S, RANGE 32 $\frac{1}{2}$ E, W. M.

North

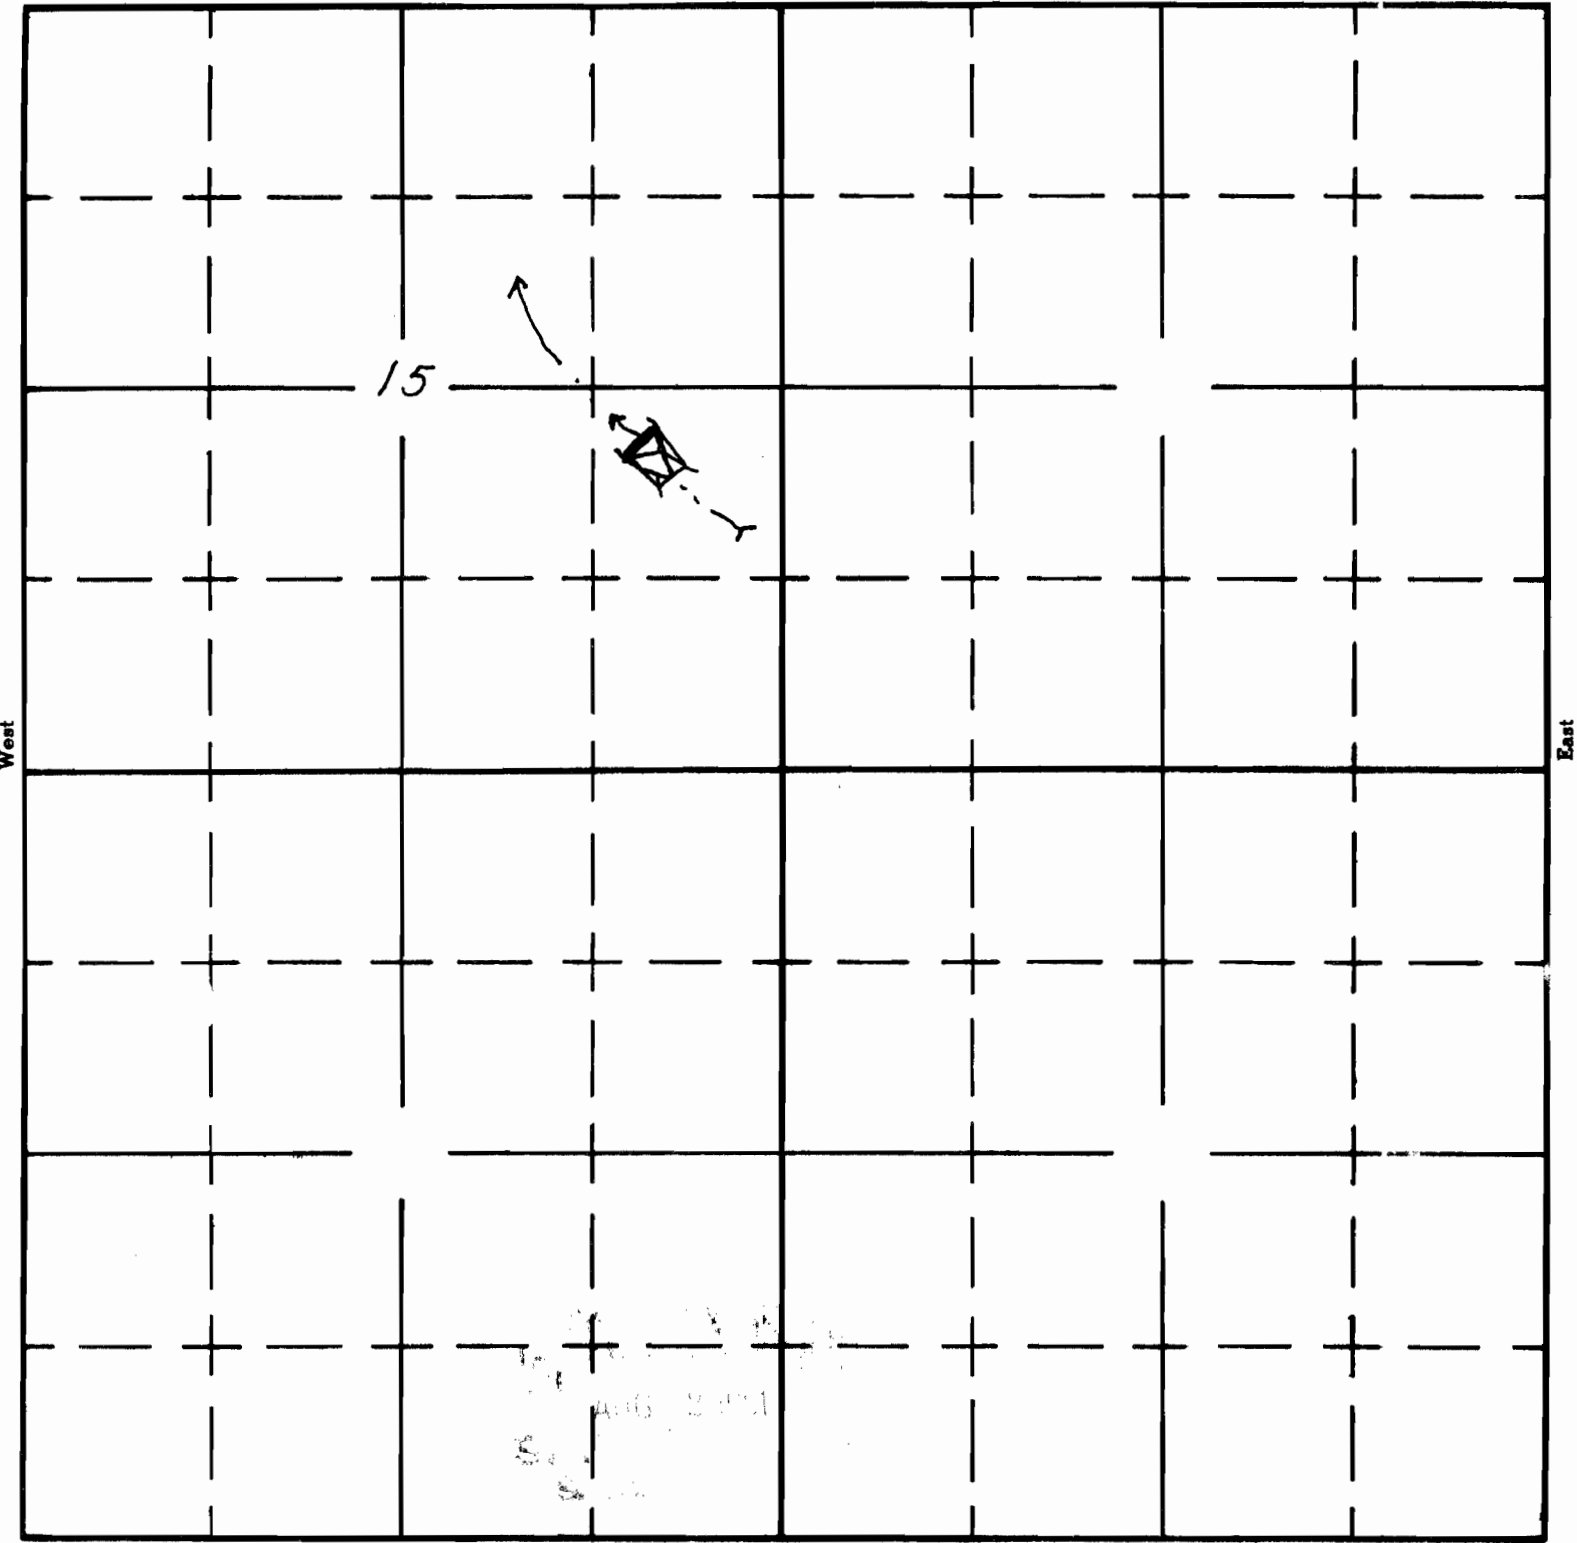

South

APPLICATION No. R-36024
PERMIT No. R-4372