

UNITED STATES
DEPARTMENT OF THE INTERIOR
BUREAU OF LAND MANAGEMENT

SECTION


SW 1/4 NE 1/4

Oregon State Water Filings

TOWNSHIP 28S, RANGE 29 1/2 E, W. M.

Sec. 25

North

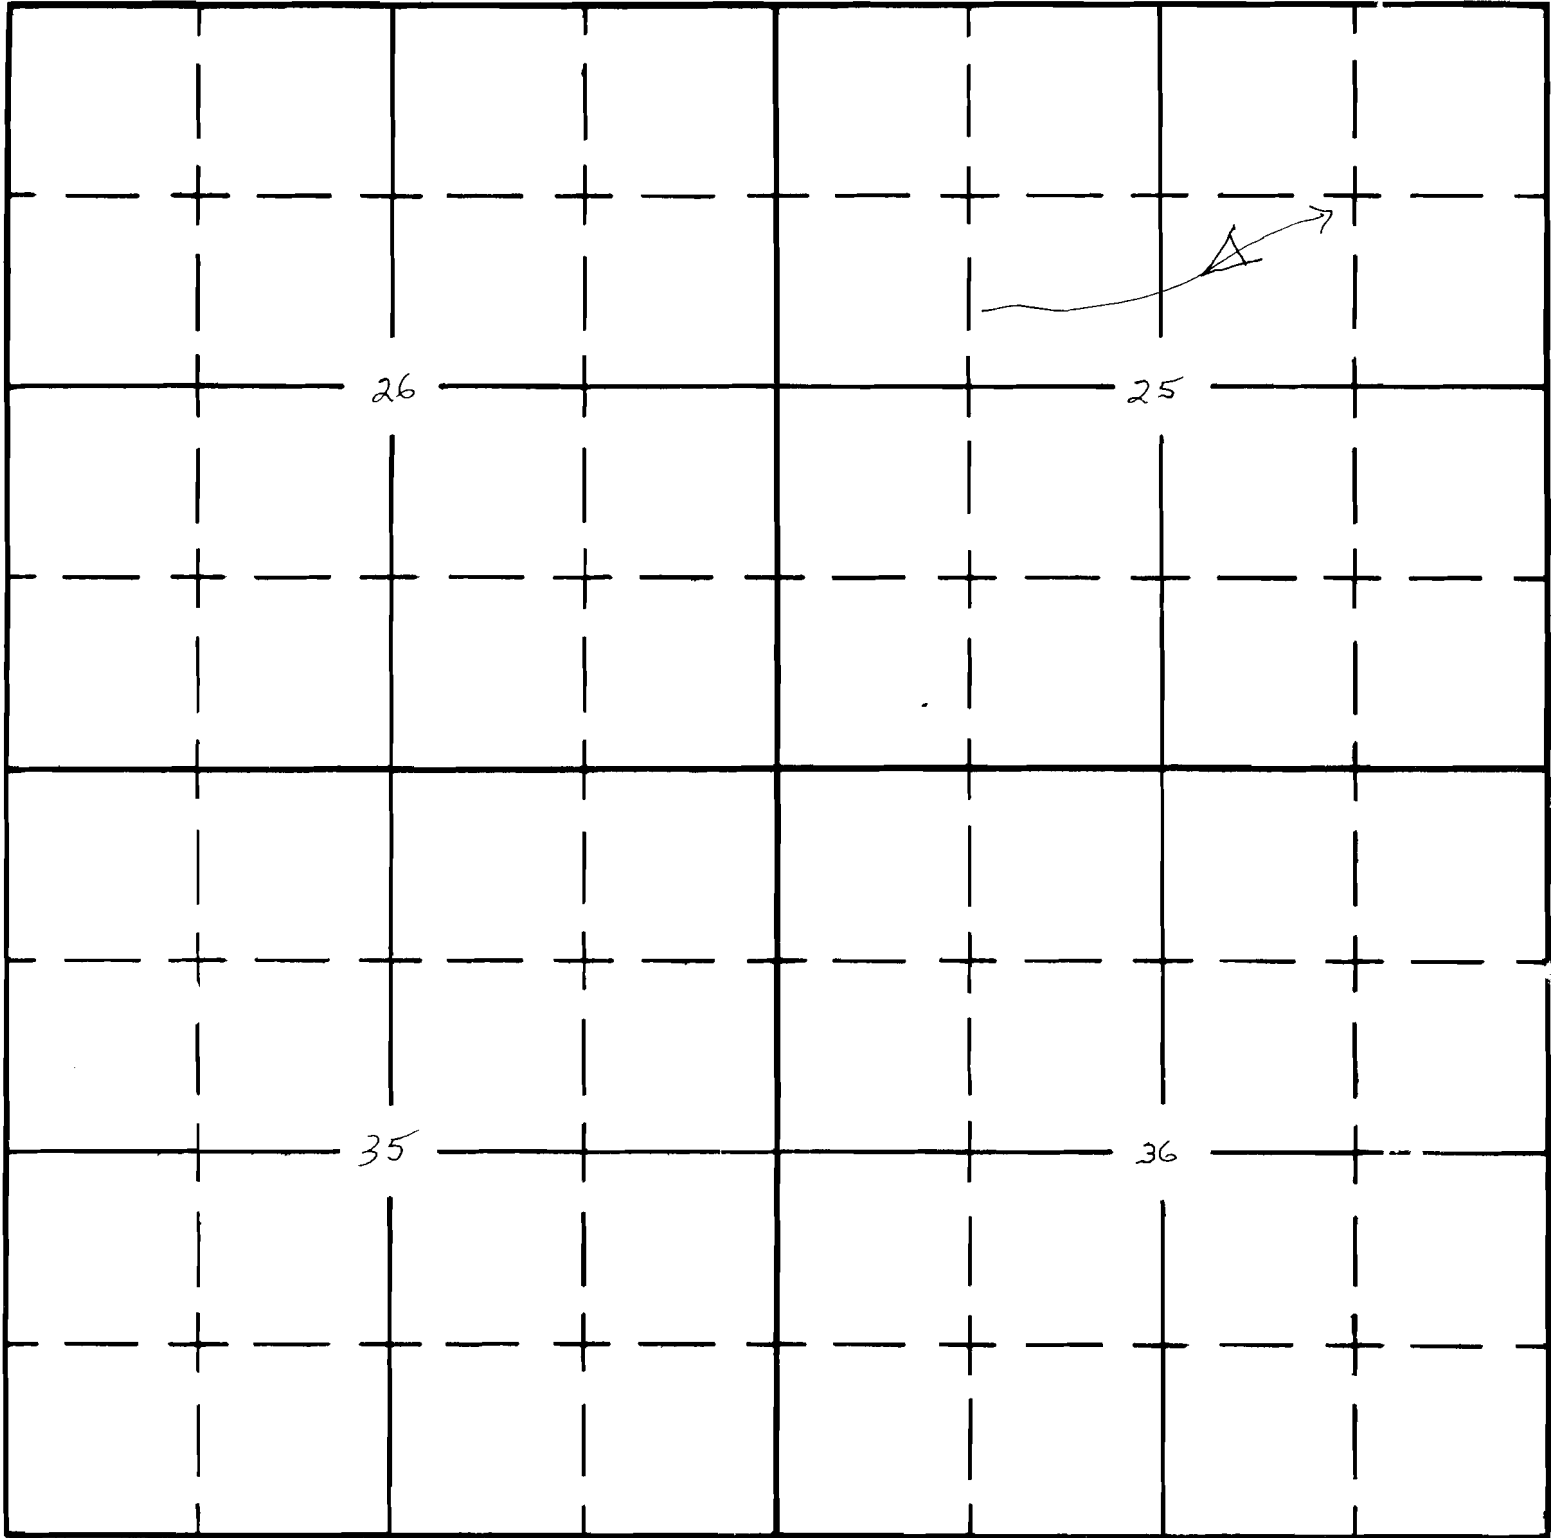

South

APPLICATION No. R-39326

PERMIT No. 44725