

UNITED STATES
DEPARTMENT OF THE INTERIOR
BUREAU OF LAND MANAGEMENT

SECTION


Oregon State Water Filings

SE 1/4 SW 1/4

TOWNSHIP 28S, RANGE 29 1/2 E, W. M.

Sec. 24

North

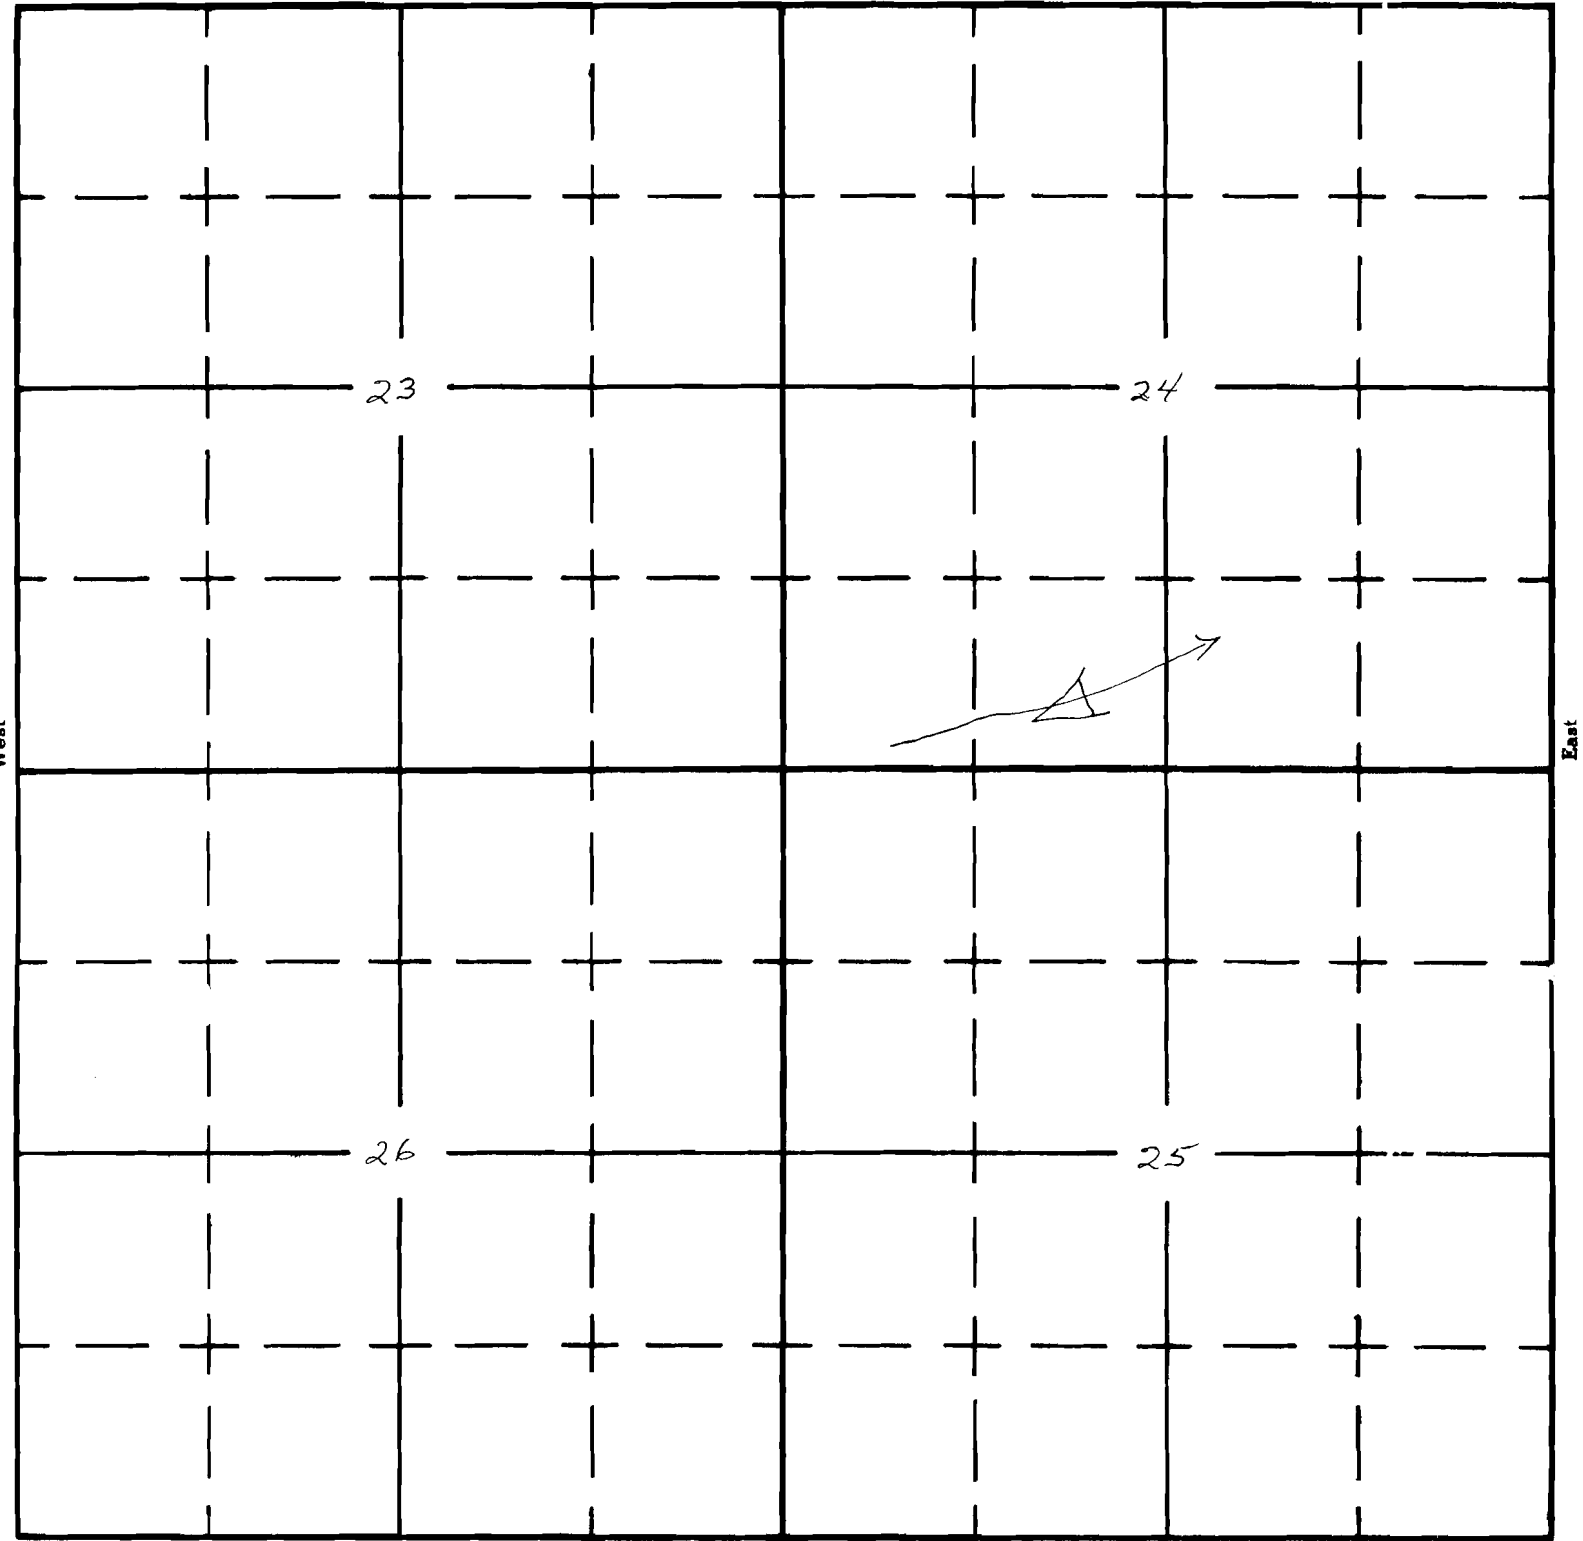

South