

UNITED STATES
DEPARTMENT OF THE INTERIOR
BUREAU OF LAND MANAGEMENT

SECTION


Oregon State Water Filings

SE 1/4 NW 1/4

TOWNSHIP 22S, RANGE 30E, W. M.

Sec. 21

North

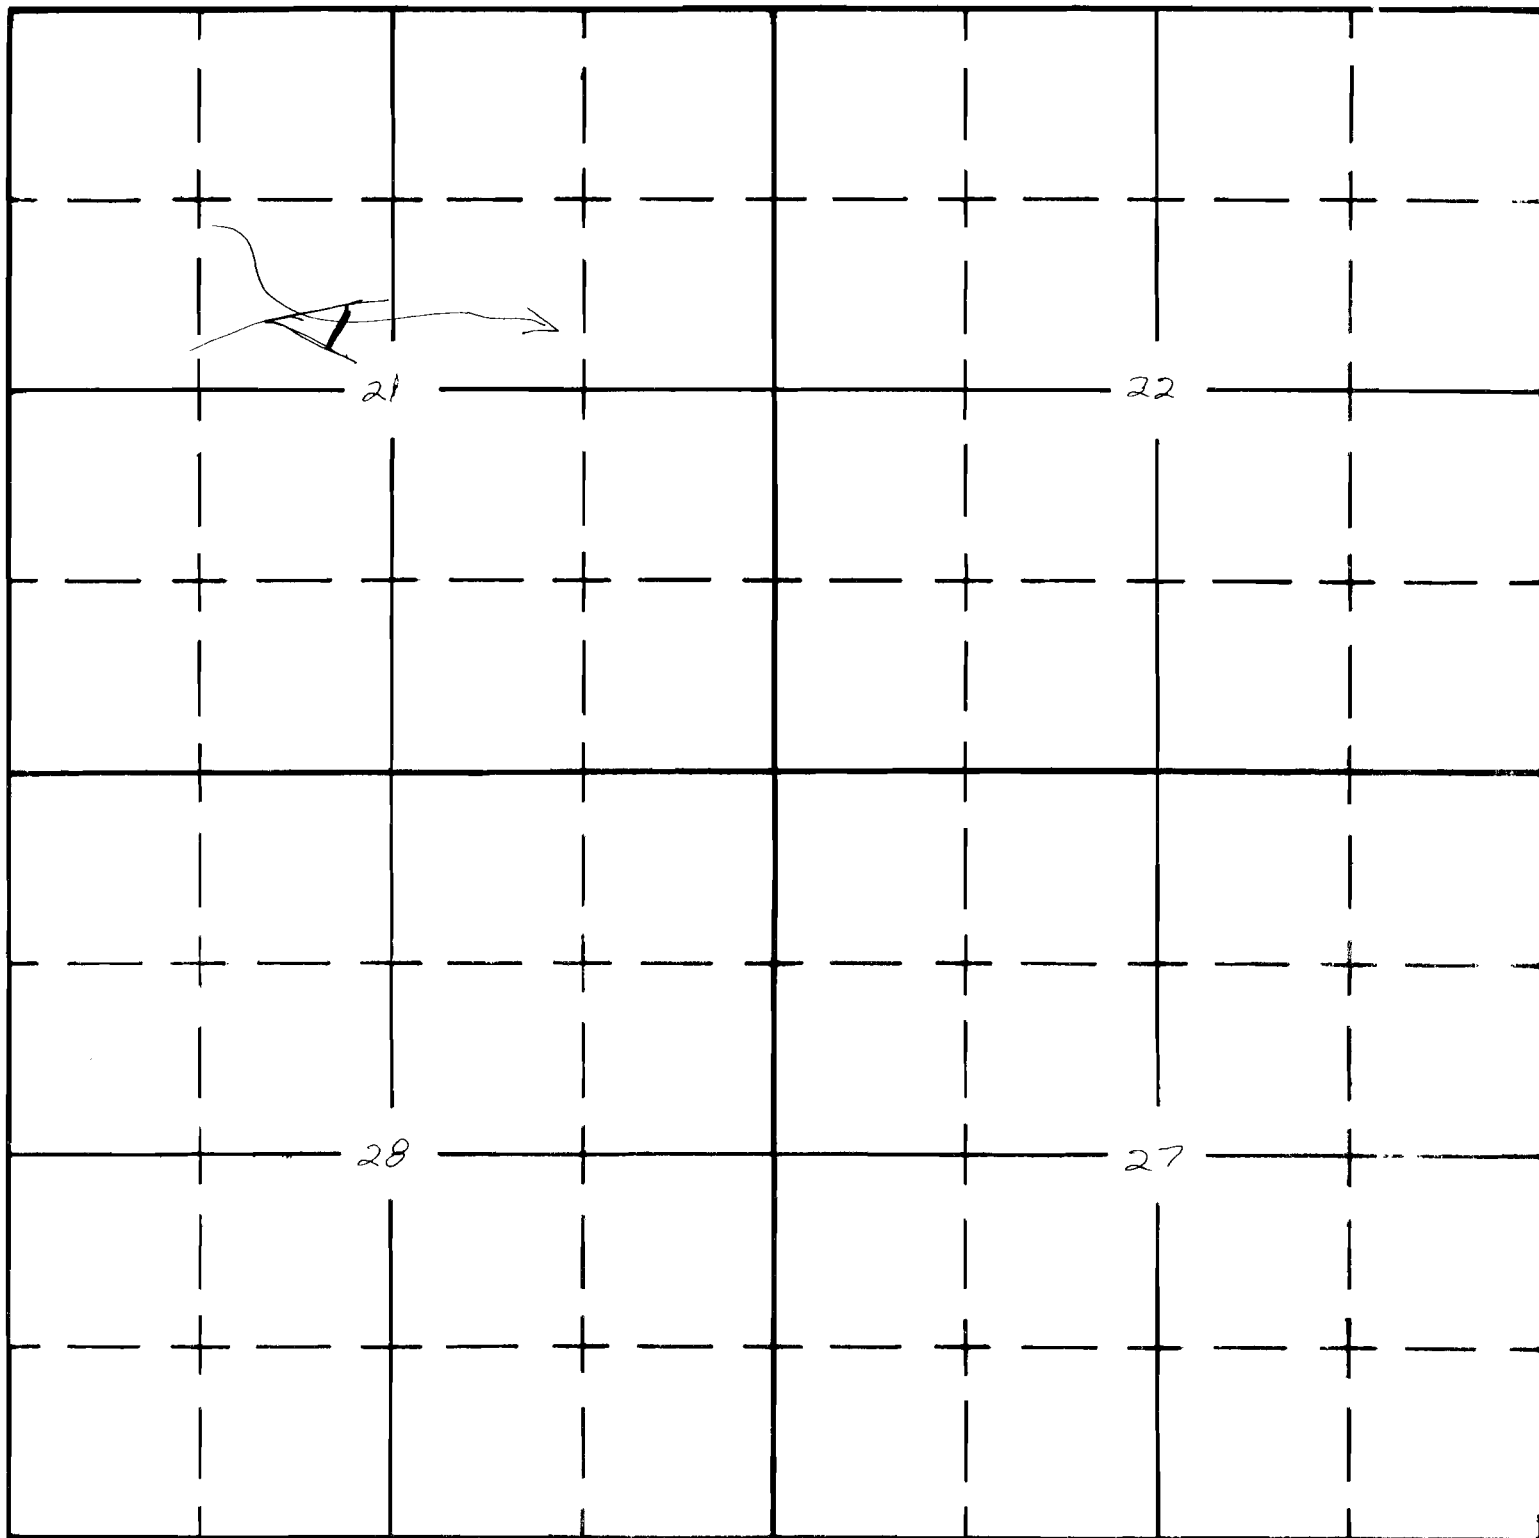

South

APPLICATION No. W-31348
PERMIT No. 2-1-1