


Oregon State Water Filings

TOWNSHIP 22S, RANGE 30E, W. M.

North

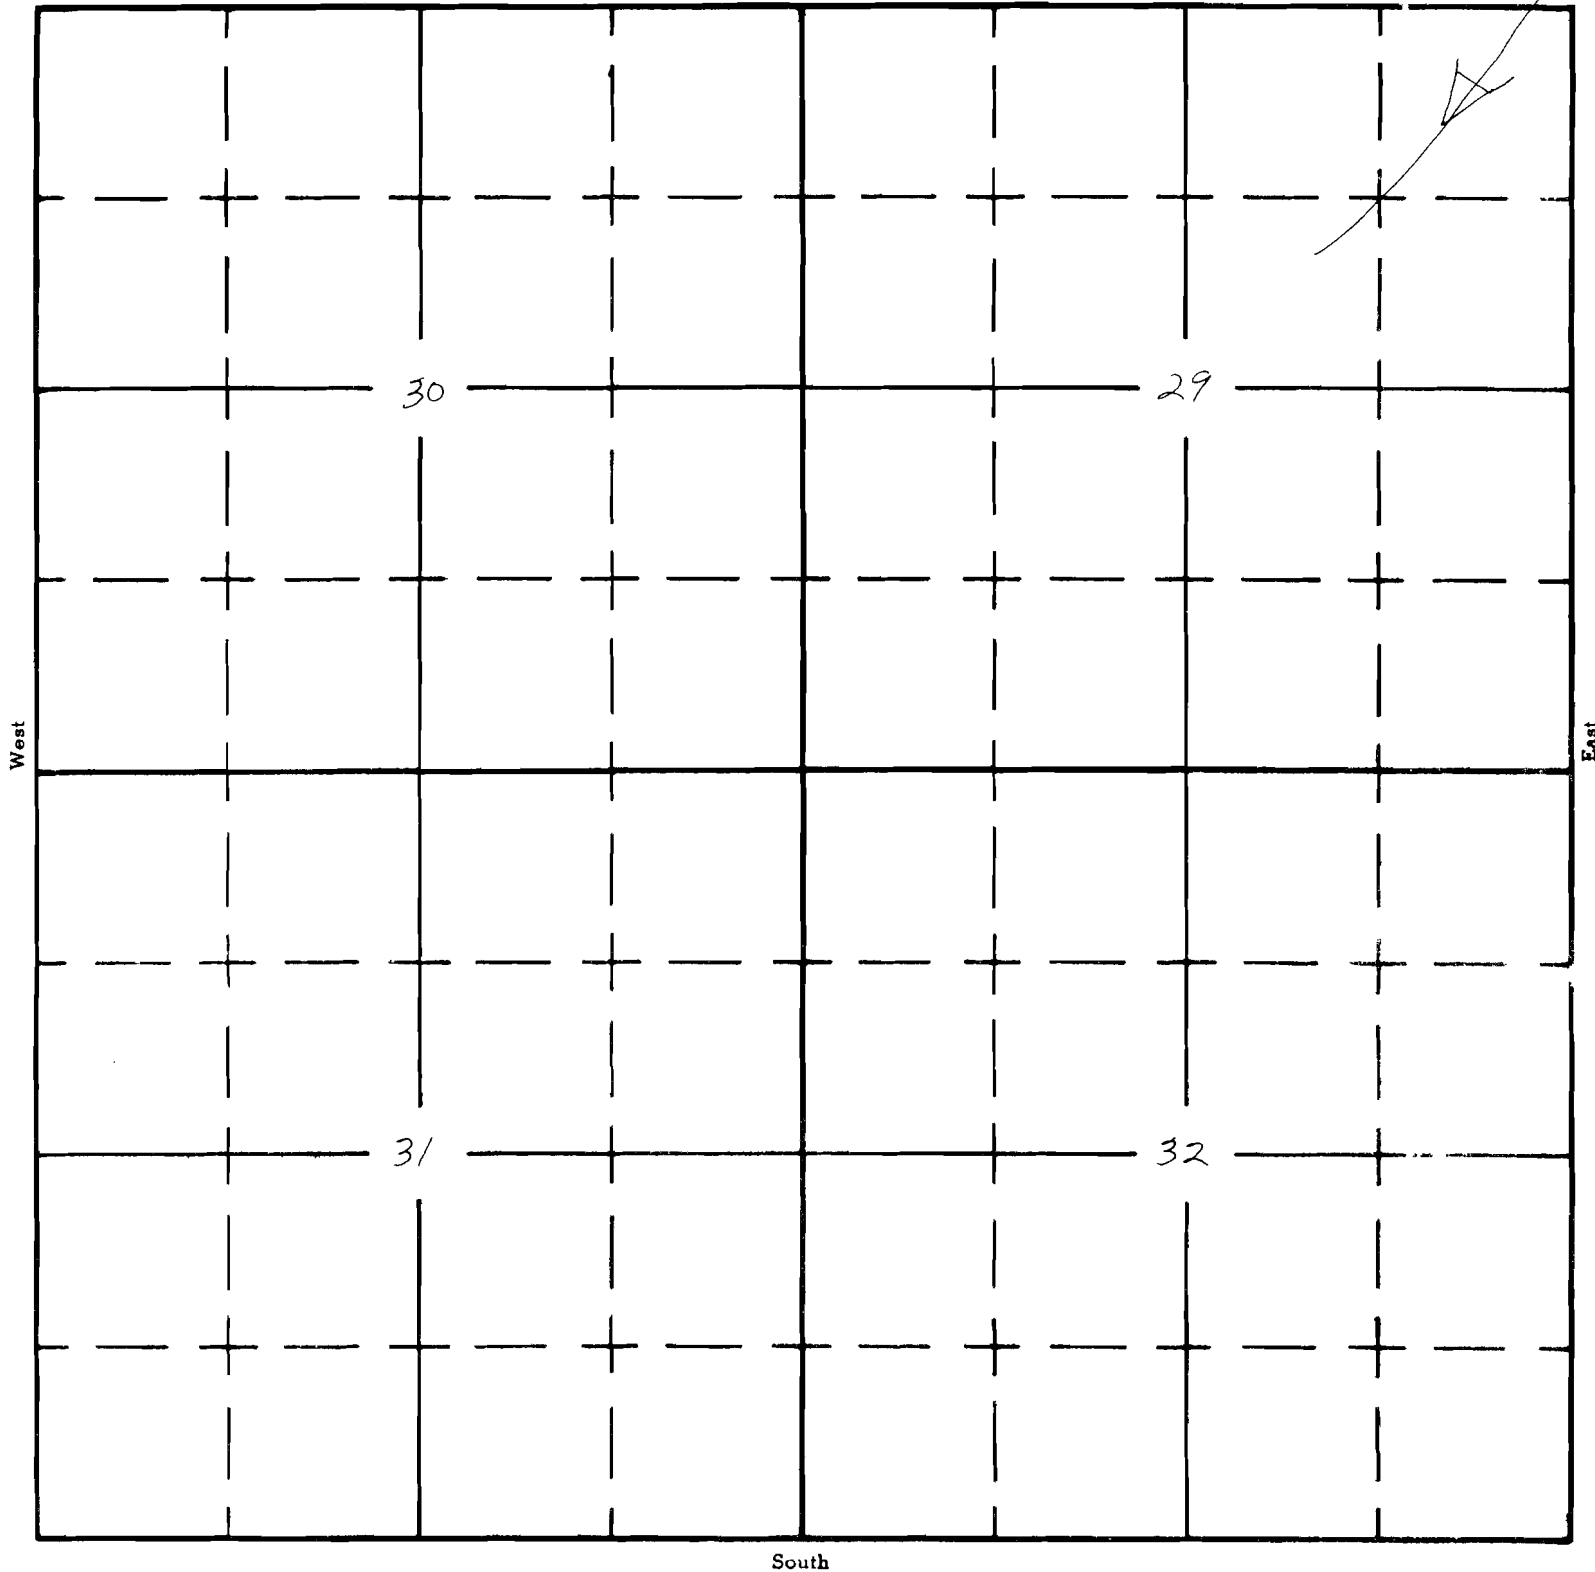

APPLICATION No. 17-3247
PERMIT No. 17-32