

Form AI-187
March 1961

UNITED STATES
DEPARTMENT OF THE INTERIOR
BUREAU OF LAND MANAGEMENT


SECTION 23

Oregon State Water Filings

NW 1/4 NE 1/4

TOWNSHIP 31S, RANGE 32 1/2 E, W. M.

North

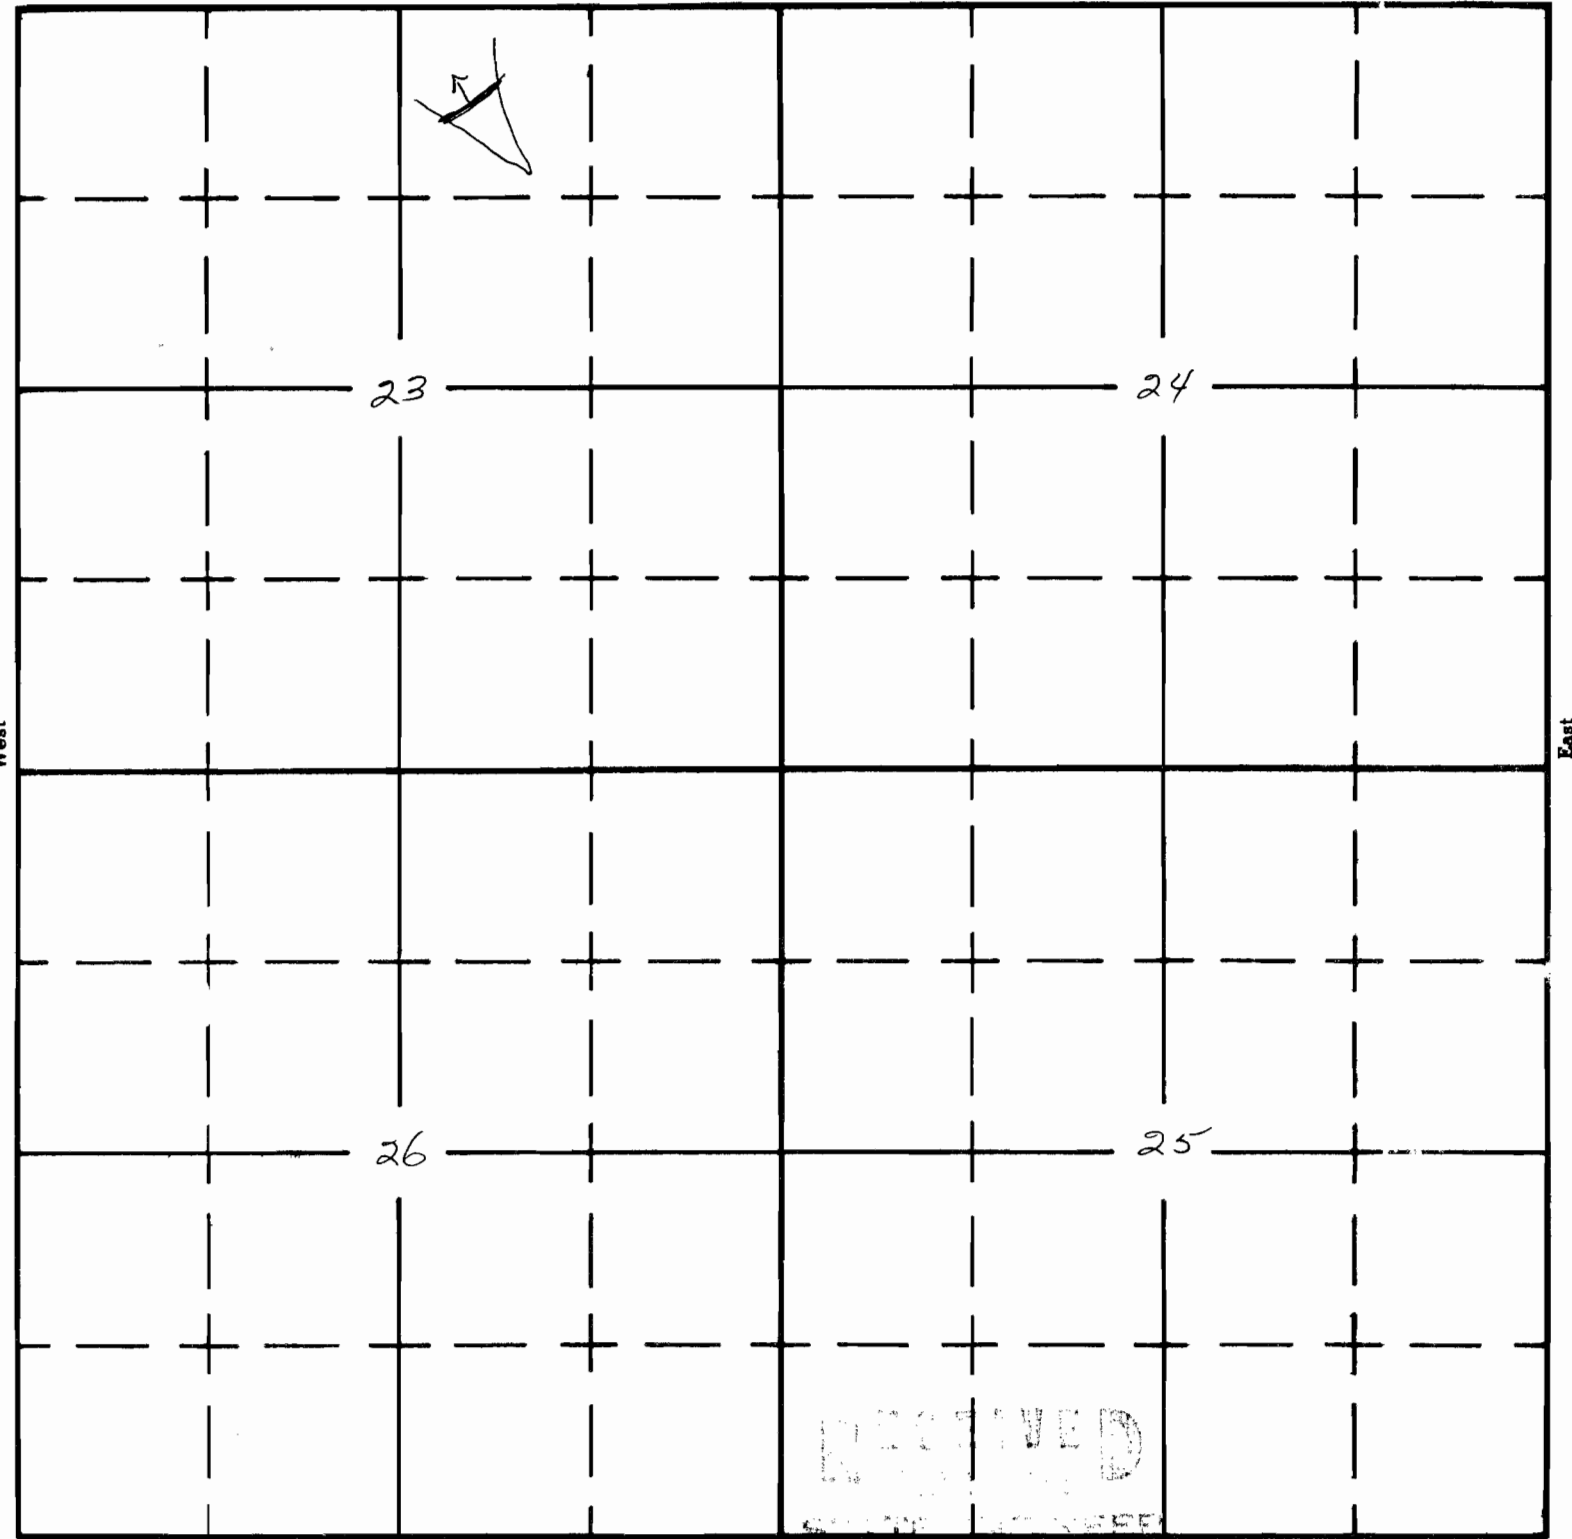

South

APPLICATION No. R-40593
PERMIT No. R-4741