


UNITED STATES
DEPARTMENT OF THE INTERIOR
BUREAU OF LAND MANAGEMENT

SECTION 30
NW 1/4 NW 1/4

Oregon State Water Filings
TOWNSHIP 31 S, RANGE 32 3/4, W. M.

North

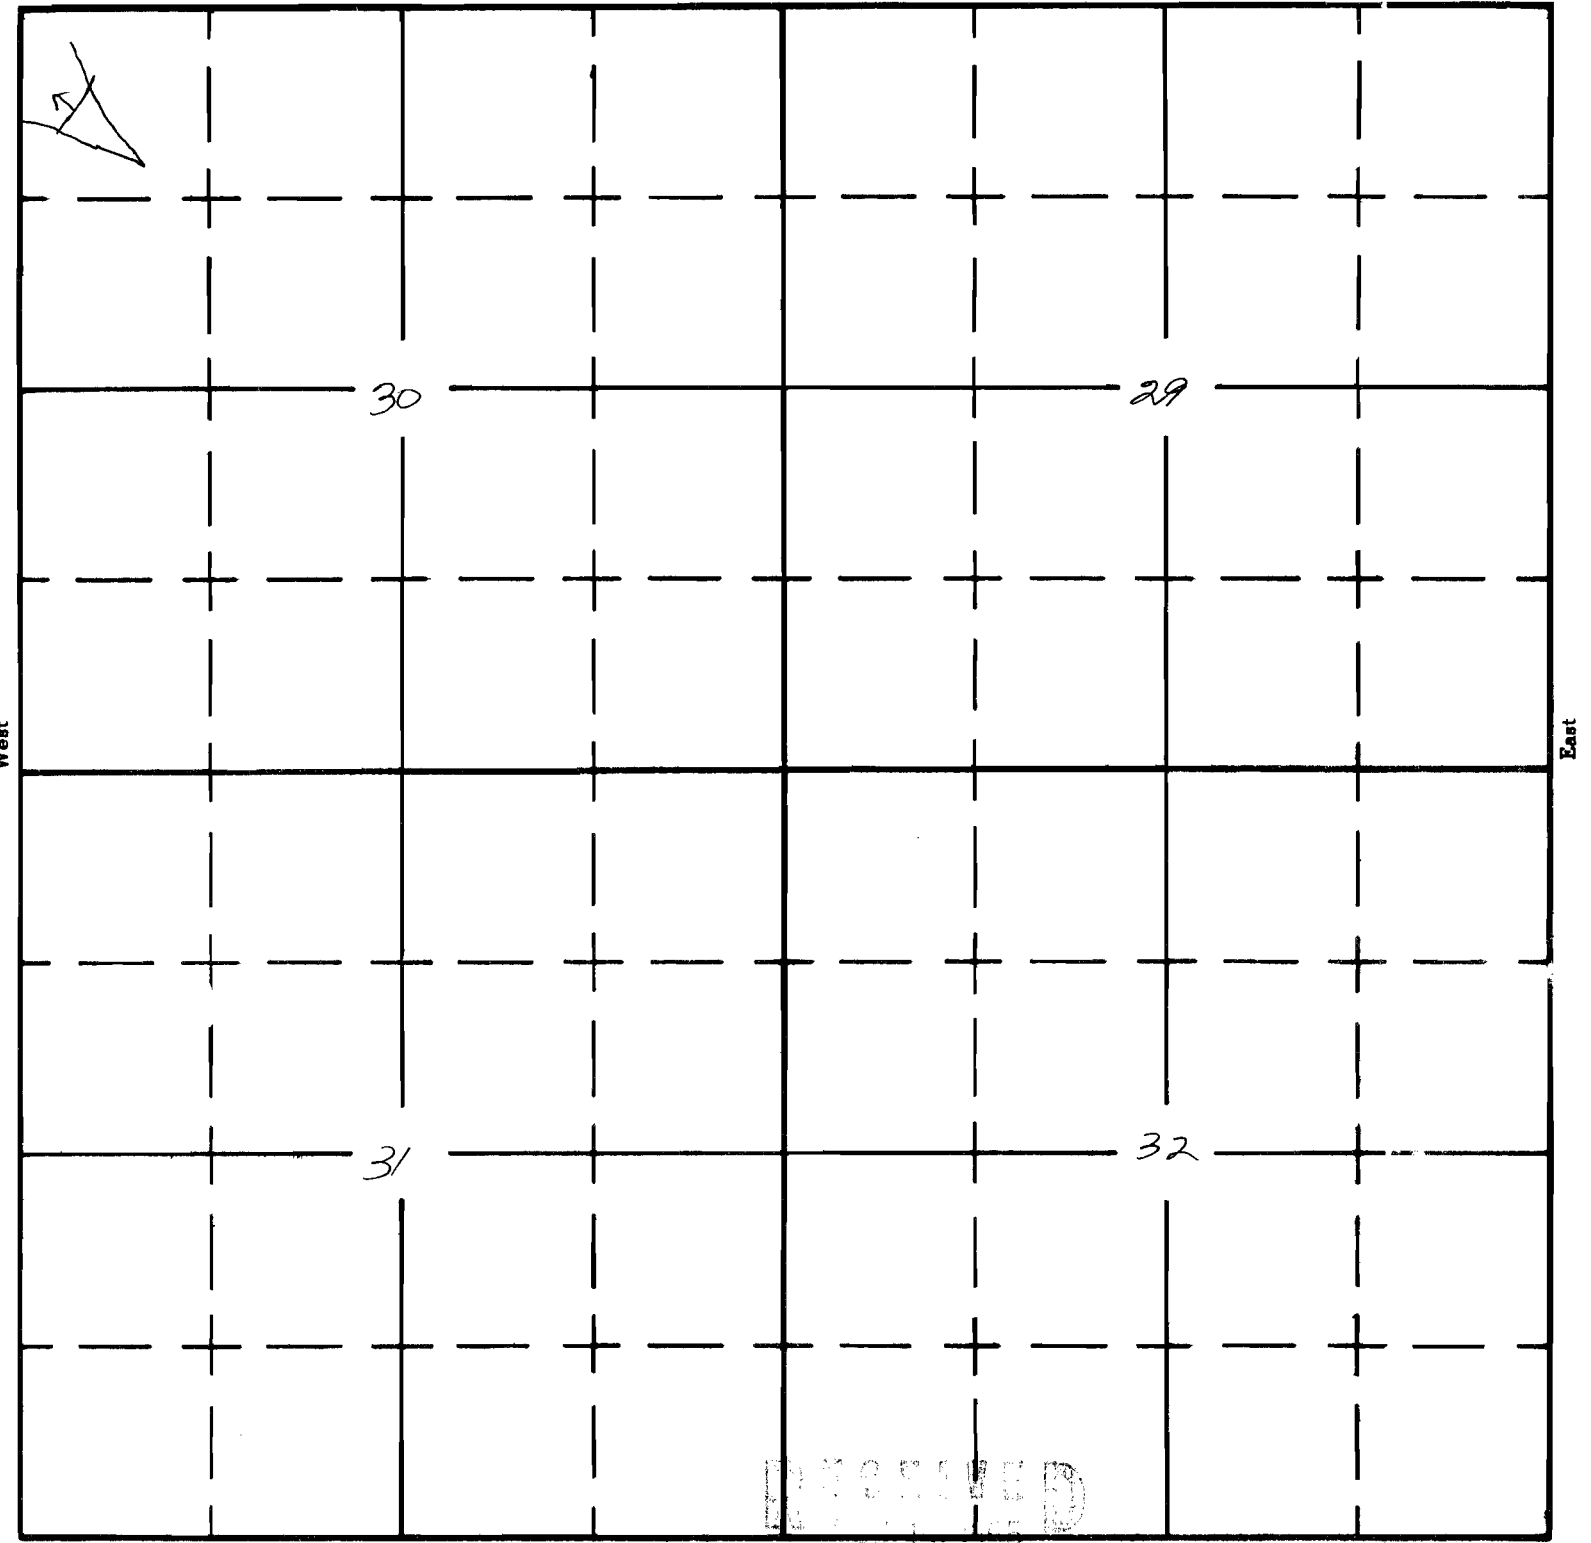

RECEIVED
STATE ENGINEER

APPLICATION No. R-40594
PERMIT No. R-4742