

UNITED STATES
DEPARTMENT OF THE INTERIOR
BUREAU OF LAND MANAGEMENT


SECTION

Oregon State Water Filings

SW 1/4 NW 1/4
15

TOWNSHIP 31-S, RANGE 32 1/2 E, W. M.

North

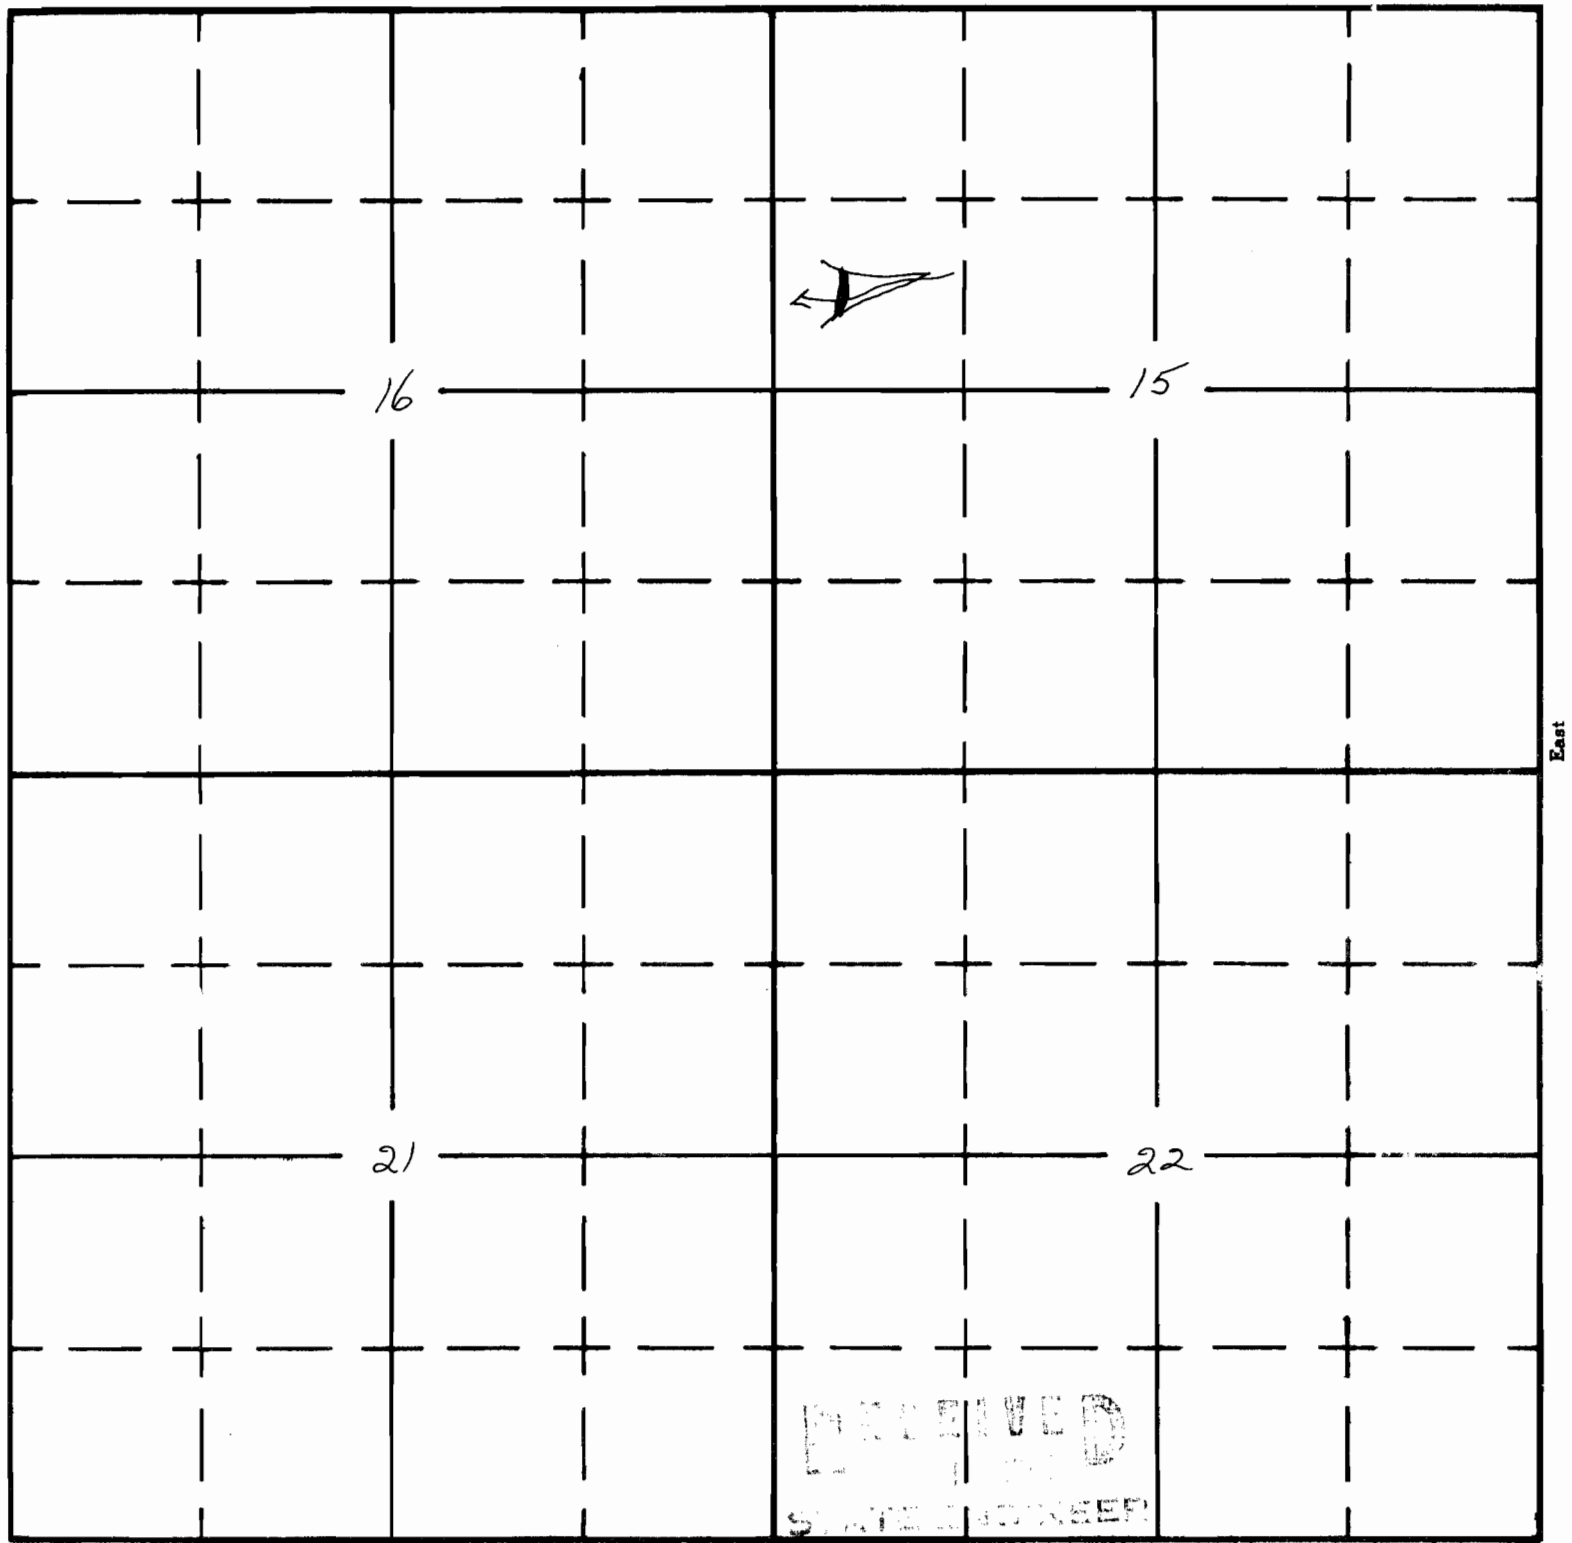

South

RECEIVED
STATE ENGINEER

APPLICATION No. R 40595

PERMIT No. R-4743