

Form A1-187
March 1961

UNITED STATES
DEPARTMENT OF THE INTERIOR
BUREAU OF LAND MANAGEMENT


SECTION 14

Oregon State Water Filings

NE 1/4 SE 1/4

TOWNSHIP 31 S, RANGE 32 1/2 E, W. M.

North

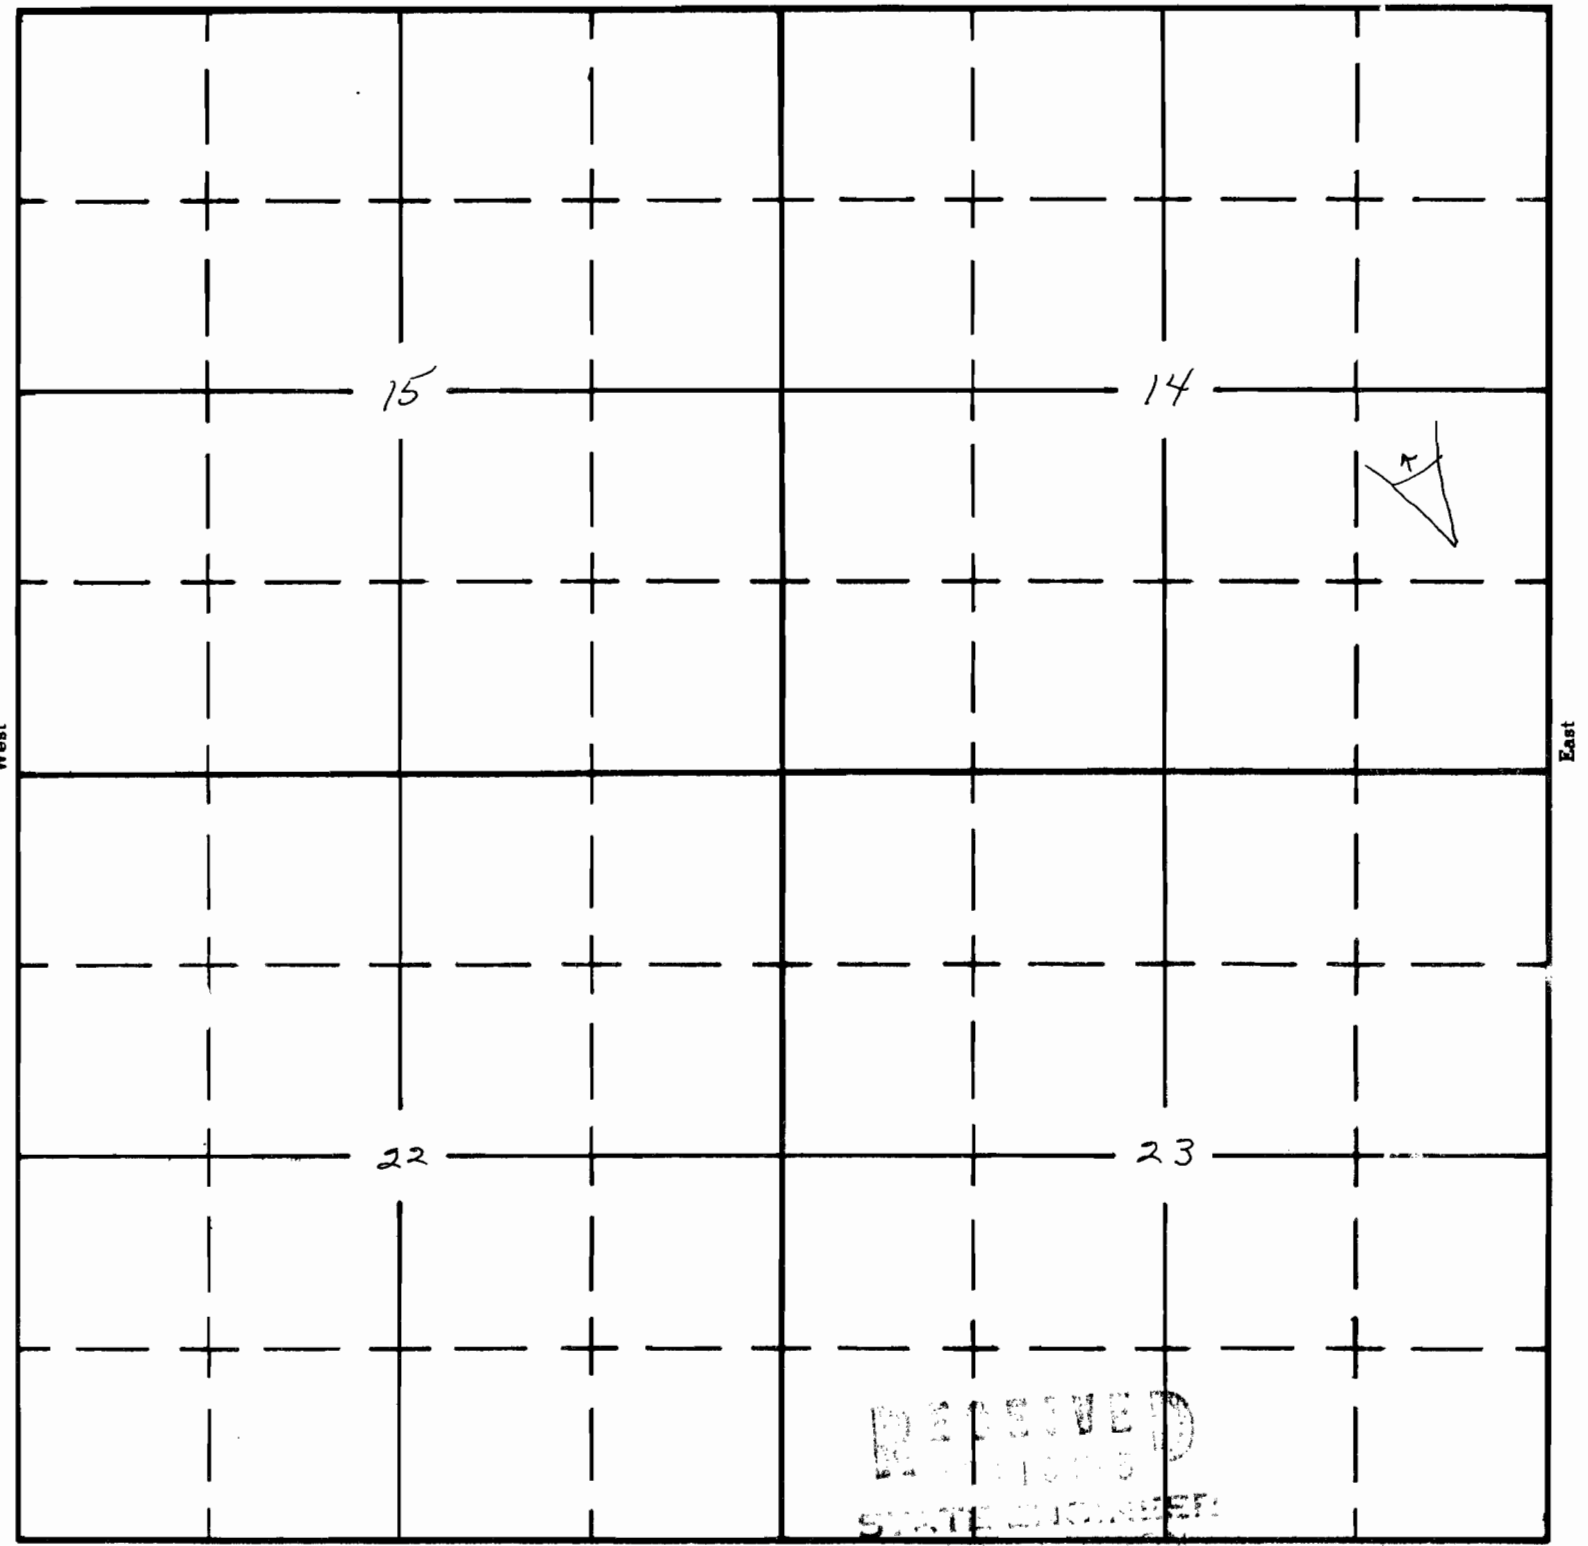

South

APPLICATION No. R 40596
PERMIT No. R-4744