

Form AI-187
March 1961

UNITED STATES
DEPARTMENT OF THE INTERIOR
BUREAU OF LAND MANAGEMENT

SECTION


SE $\frac{1}{4}$ SW $\frac{1}{4}$

Oregon State Water Filings

SEC. 21

TOWNSHIP 29 S, RANGE 30 E, W. M.

North

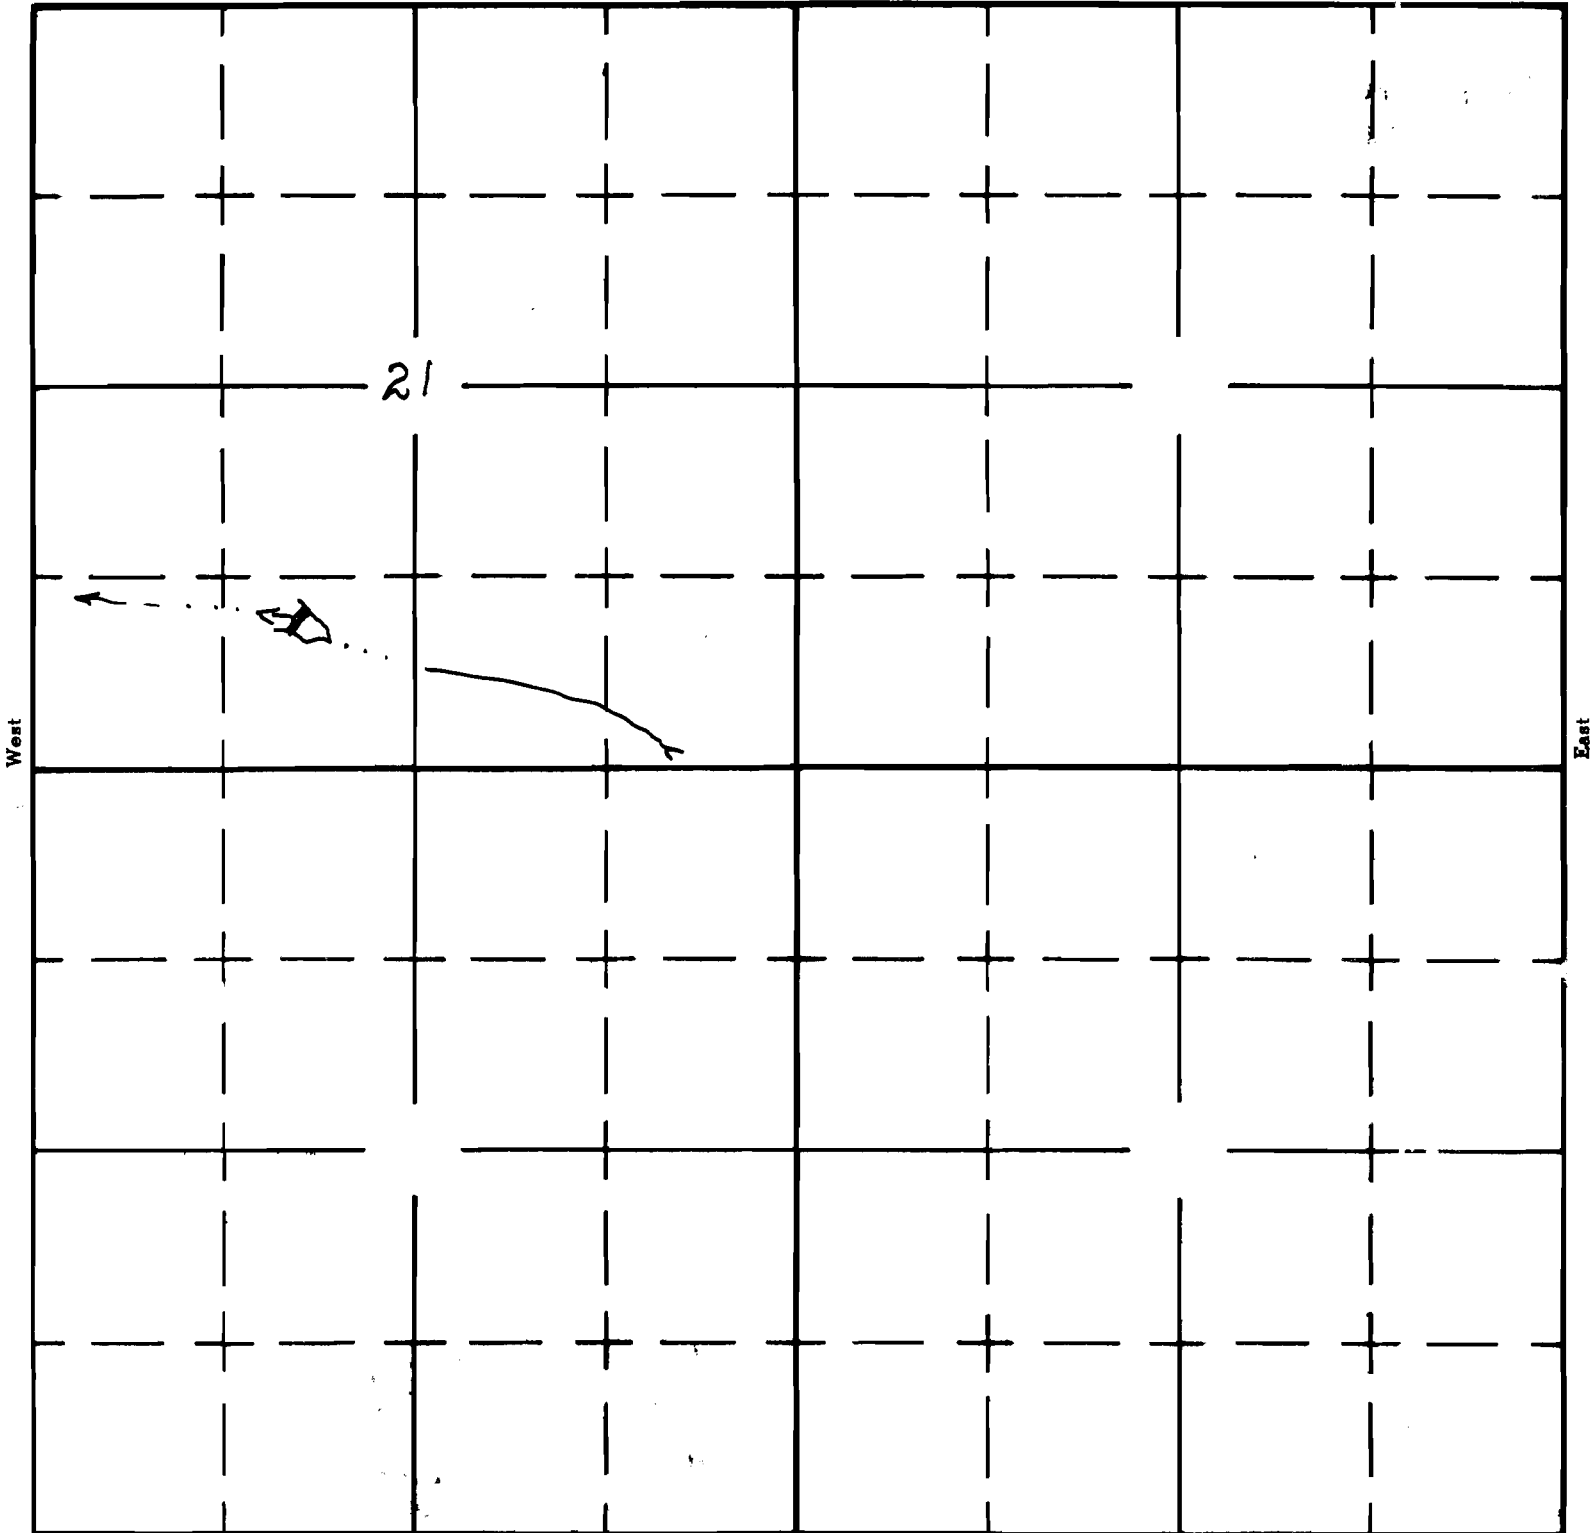

South

APPLICATION No. R-35606
PERMIT No. R 0700