

UNITED STATES
DEPARTMENT OF THE INTERIOR
BUREAU OF LAND MANAGEMENT

SECTION


SW 4 SE 4

Oregon State Water Filings

33

TOWNSHIP 22S, RANGE 94E, W. M.

North

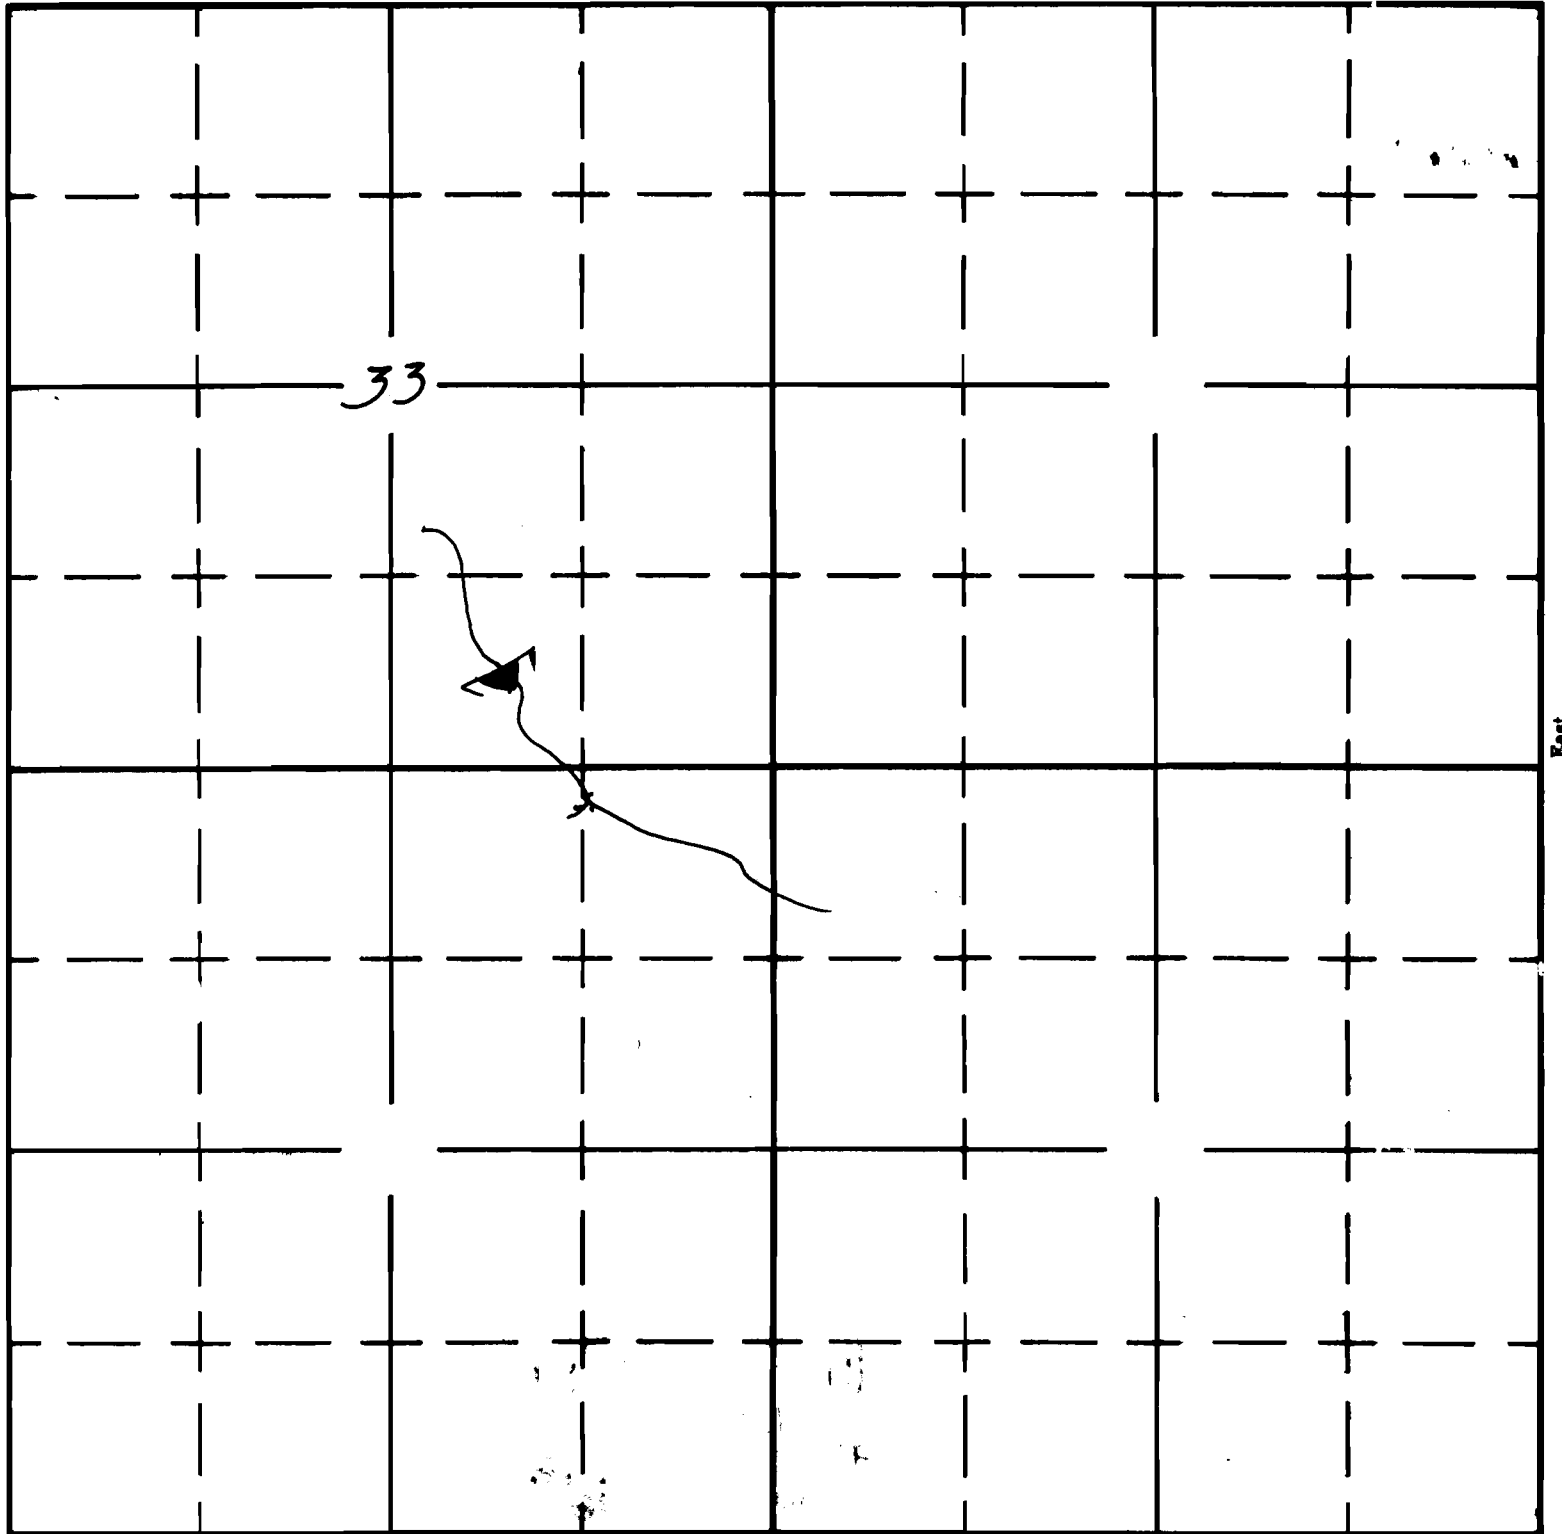

South

APPLICATION No. R-35621

PERMIT No. **6802**